City of Prince George
HISTORY SHEET

SHEET NUMBER 7041 **Roll Number** 00686021

Legal: LOT'S 47 BLOCK D.L. 4043 PLAN 20604

Address: 4580 TULIP ROAD.

Sanitary Connection: # 15579 SIZE 100mm MATERIAL INV. CONNECTED

Water Connection # SIZE 20mm MATERIAL cu METER CONNECTED

Storm Connection: # SIZE MATERIAL INV. CONNECTED

Cash Receipt No's: WATER SANITARY STORM

CURB FROM PROPERTY LINE PAVEMENT WIDTH

B.C. HYDRO UNDERGROUND CONNECTION

B.C. TELEPHONE UNDERGROUND CONNECTION

INLAND GAS

The information contained herein is for internal use only. Not to be relied upon unless confirmed by site inspection and/or investigation.

Information Sheets:

Comments: NID WATER SERVICE - ON NORTH CORNER
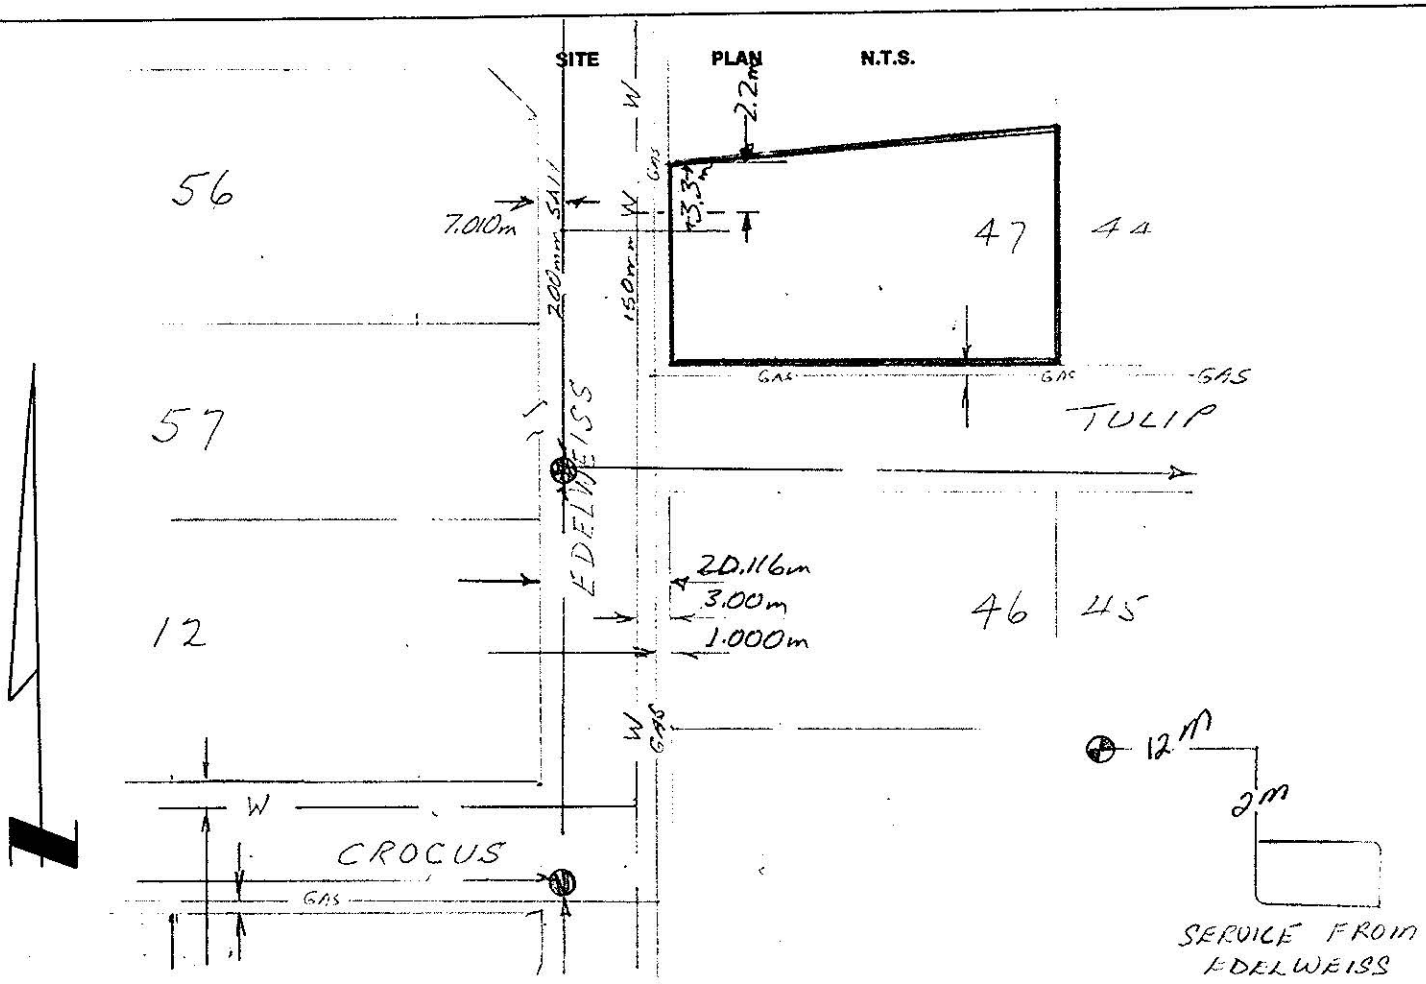
OWNER: