City of Prince George
HISTORY SHEET

0068859 26

SHEET NUMBER 5952 **Roll Number**

Legal: LOT'S 7 BLOCK D.L. 4047 PLAN 11060

Address: 4108 RICHET STREET

Sanitary Connection: # 13925 SIZE 100mm MATERIAL INV. CONNECTED

Water Connection # SIZE 20mm MATERIAL Cu METER CONNECTED

Storm Connection: # SIZE MATERIAL INV. CONNECTED

Cash Receipt No's: WATER SANITARY STORM

CURB FROM PROPERTY LINE PAVEMENT WIDTH

B.C. HYDRO O/H UNDERGROUND CONNECTION

B.C. TELEPHONE O/H UNDERGROUND CONNECTION

INLAND GAS AS SHOWN

Information Sheets:

Comments: WITH THAW WIRE

OWNER: BISSELL STANLEY THOMAS & MARLENE ANN MARY 1/7/75
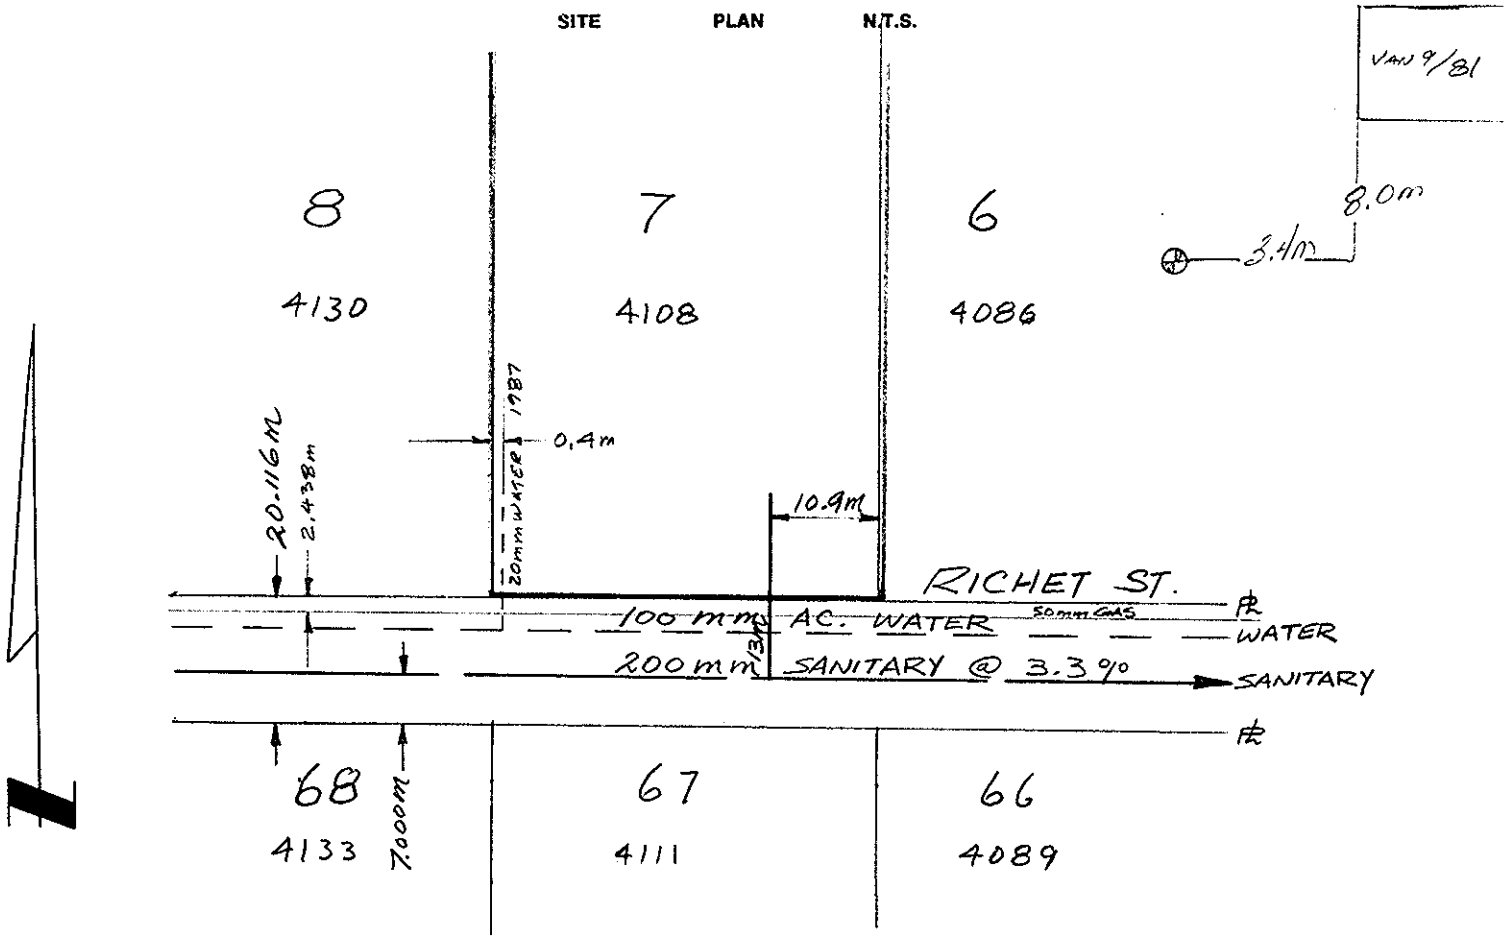
SITE PLAN N.T.S.