City of Prince George

# History Sheet

| | |
|---|---|
| PID: | 006935354 |
| SD/MU: | |
| WO: | |

Civic Address: 3687 Pinewood Ave

Legal Description: Lot: 2 District Lot: 8177 Plan: 26548

| Service Type | Diameter (mm) | Material | Invert Elev at main (m) | Invert Elev at property line (m) | Invert Depth at service end (m) | Distance into property (m) | Installation Date |
|---|---|---|---|---|---|---|---|
| Sanitary | 100mm | AC | - | 596.36 | 2.74 | - | December 1976 |
| Water | 20mm | Plastic | - | - | - | - | December 1976 |
| Storm | N/A | N/A | - | - | - | - | |

| Service Connection Location | | | | Sanitary (m) | Storm (m) |
|---|---|---|---|---|---|
| Distance from downstream San MH | 1769 | towards upstream San MH | 1770 | 81.69 | |
| Distance from downstream Stm MH | - | towards upstream Stm MH | - | | |

| Power | Size | Communications | Size | Cable | Size | Gas | Size |
|---|---|---|---|---|---|---|---|
| BC Hydro | - | Telus | - | Shaw | - | FortisBC | - |
| Underground Service | | Underground Service | | Underground Service | | | |

| | | | |
|---|---|---|---|
| Installed by: | City of Prince George forces | Survey Date: | - |
| Comments: | | | |
| | | | |
| | | | |

**NOT TO SCALE The information contained herein is for internal use only.**
**Not to be relied on unless confirmed by site inspection and/or investigation.**

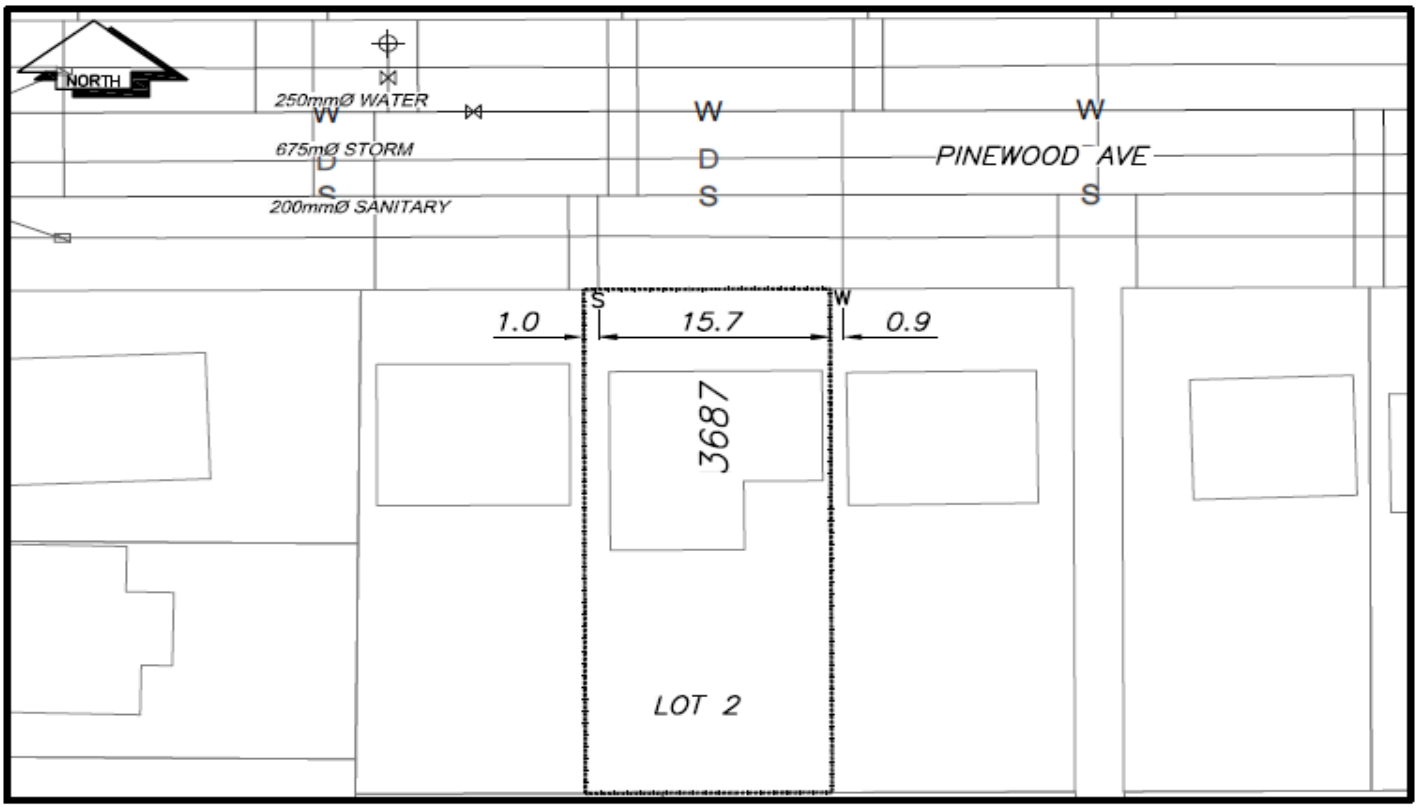


LEGEND:

| | | | | | |
|---|---|---|---|---|---|
| CS | CURB STOP | W | WATER SERVICE | D | STORM SERVICE |
| CO | CLEAN OUT | S | SANITARY SERVICE | G | GAS |
| | WATER VALVE | | FIRE HYDRANT | | ENCUMBERANCE |

**NOT TO SCALE**