City of Prince George
HISTORY SHEET

SHEET NUMBER № 0522 **Roll Number** 009116373

Legal: LOT'S 27 BLOCK D.L. 937 PLAN 9107

Address: 2615 1ST AVE.

Sanitary Connection: # 727 SIZE MATERIAL INV. CONNECTED

Water Connection # 2027 SIZE 3/4" MATERIAL Copper. METER CONNECTED

Storm Connection: # SIZE MATERIAL INV. CONNECTED

Cash Receipt No's: WATER SANITARY STORM

CURB FROM PROPERTY LINE PAVEMENT WIDTH

B.C. HYDRO UNDERGROUND CONNECTION

B.C. TELEPHONE UNDERGROUND CONNECTION

INLAND GAS

Information Sheets:

Comments:
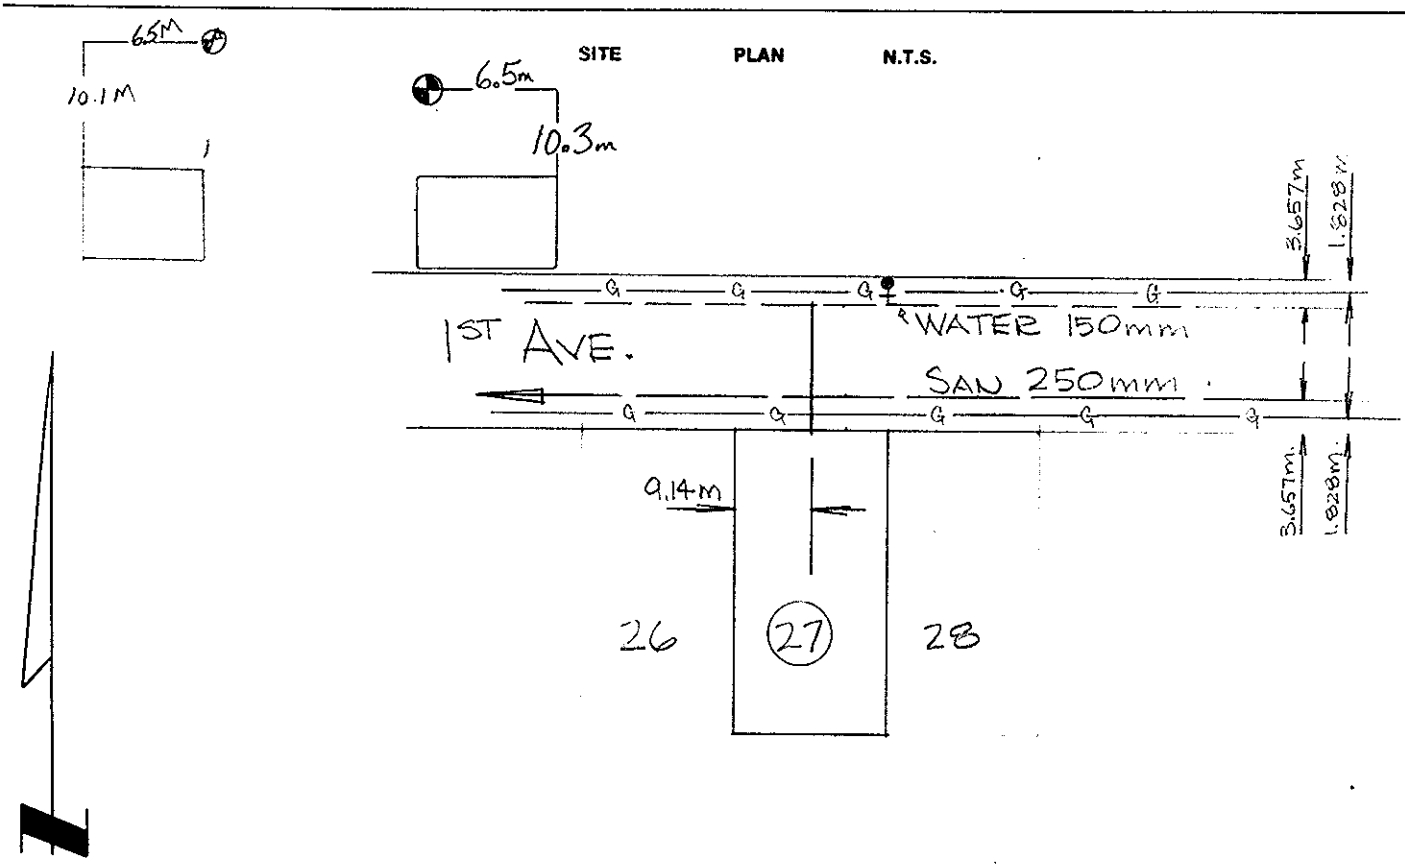
SITE PLAN N.T.S.