124

City of Prince George
HISTORY SHEET

1974 SFG assessment

SHEET NUMBER 8230 **Roll Number** 20 F 317.000

Legal: LOT'S 5-6 BLOCK 24 D.L. 933 PLAN 727

Address: 1341 Clark Avenue (VILLAGE AVE.)

Sanitary Connection: # SIZE 4" MATERIAL AC INV. CONNECTED 1971

Water Connection # SIZE 3/4" MATERIAL CU METER CONNECTED yes

Storm Connection: # SIZE MATERIAL INV. CONNECTED

Cash Receipt No's: WATER pd SANITARY pd STORM

CURB FROM PROPERTY LINE PAVEMENT WIDTH

B.C. HYDRO OH UNDERGROUND CONNECTION

B.C. TELEPHONE OH UNDERGROUND CONNECTION

INLAND GAS

Information Sheets:

Comments:
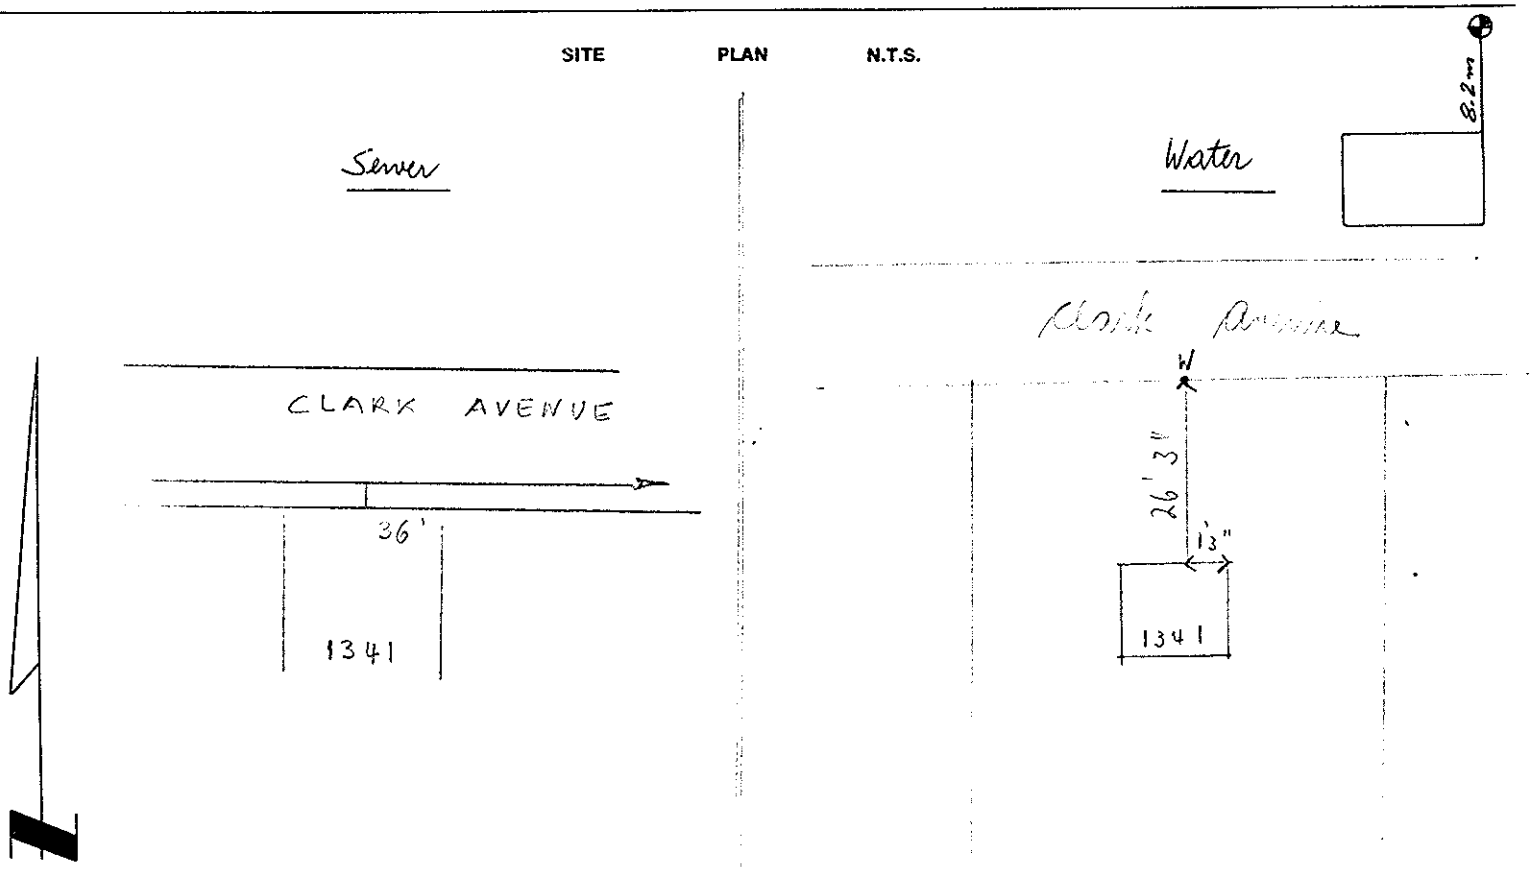
SITE PLAN N.T.S.