City of Prince George
HISTORY SHEET

D 5

SHEET NUMBER № 4042 **Roll Number** 007148 470

Legal: LOT'S 5 BLOCK D.L. 4047 PLAN 26390

Address: 6092 SPRINGALL RD.

Sanitary Connection: # 12859 SIZE 4" MATERIAL PVC INV. CONNECTED

Water Connection # 12959 SIZE ¾" MATERIAL Cu METER CONNECTED

Storm Connection: # SIZE MATERIAL INV. CONNECTED

Cash Receipt No's: WATER 57094 SANITARY 57095 STORM

CURB FROM PROPERTY LINE PAVEMENT WIDTH

B.C. HYDRO UNDERGROUND CONNECTION

B.C. TELEPHONE UNDERGROUND CONNECTION

INLAND GAS

Information Sheets:
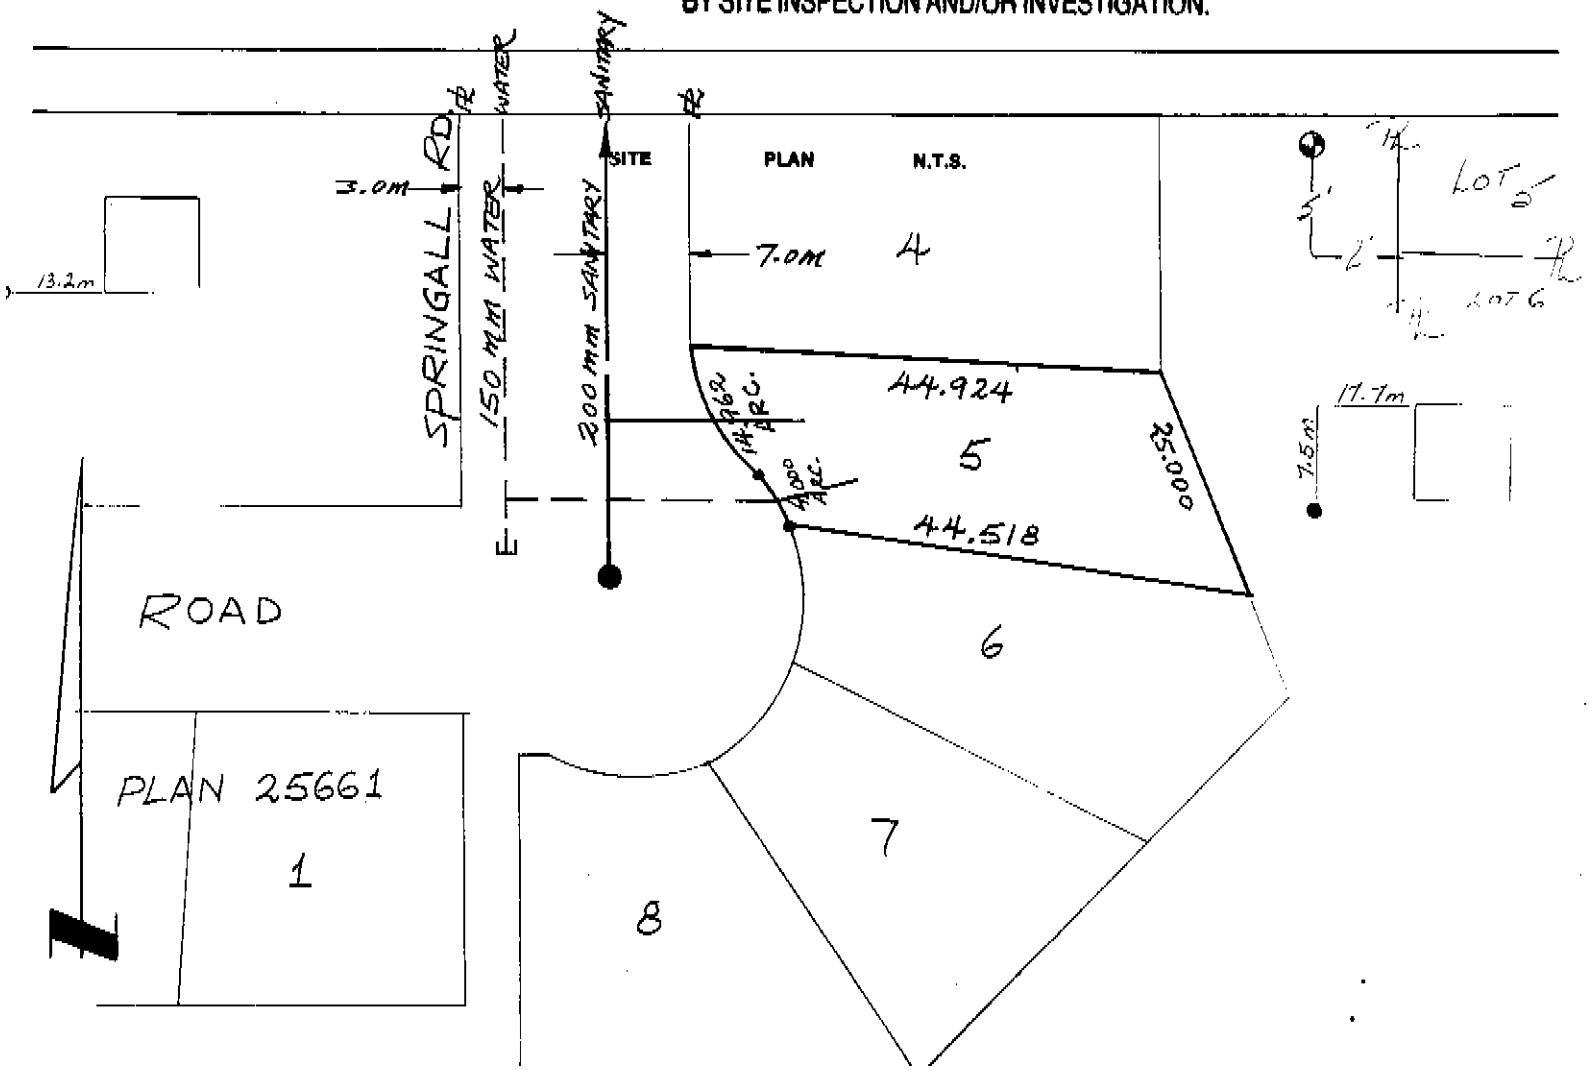
Comments: ~~THE INFORMATION CONTAINED HEREIN IS FOR INTERNAL~~ USE ONLY. NOT TO BE RELIED UPON UNLESS CONFIRMED BY SITE INSPECTION AND/OR INVESTIGATION.