City of Prince George
HISTORY SHEET

SHEET NUMBER № 0890 **Roll Number** 007-160-852

Legal: LOT'S A BLOCK D.L. 8178 PLAN 26385

Address: 3131 WESTWOOD DR.

Sanitary Connection: # 12869 SIZE 6" MATERIAL INV. CONNECTED

Water Connection # 12869 SIZE 4" MATERIAL METER CONNECTED

Storm Connection: # SIZE MATERIAL INV. CONNECTED

Cash Receipt No's: WATER 3022 SANITARY 3021 STORM

CURB FROM PROPERTY LINE PAVEMENT WIDTH

B.C. HYDRO UNDERGROUND CONNECTION

B.C. TELEPHONE UNDERGROUND CONNECTION

INLAND GAS

Information Sheets:

Comments:
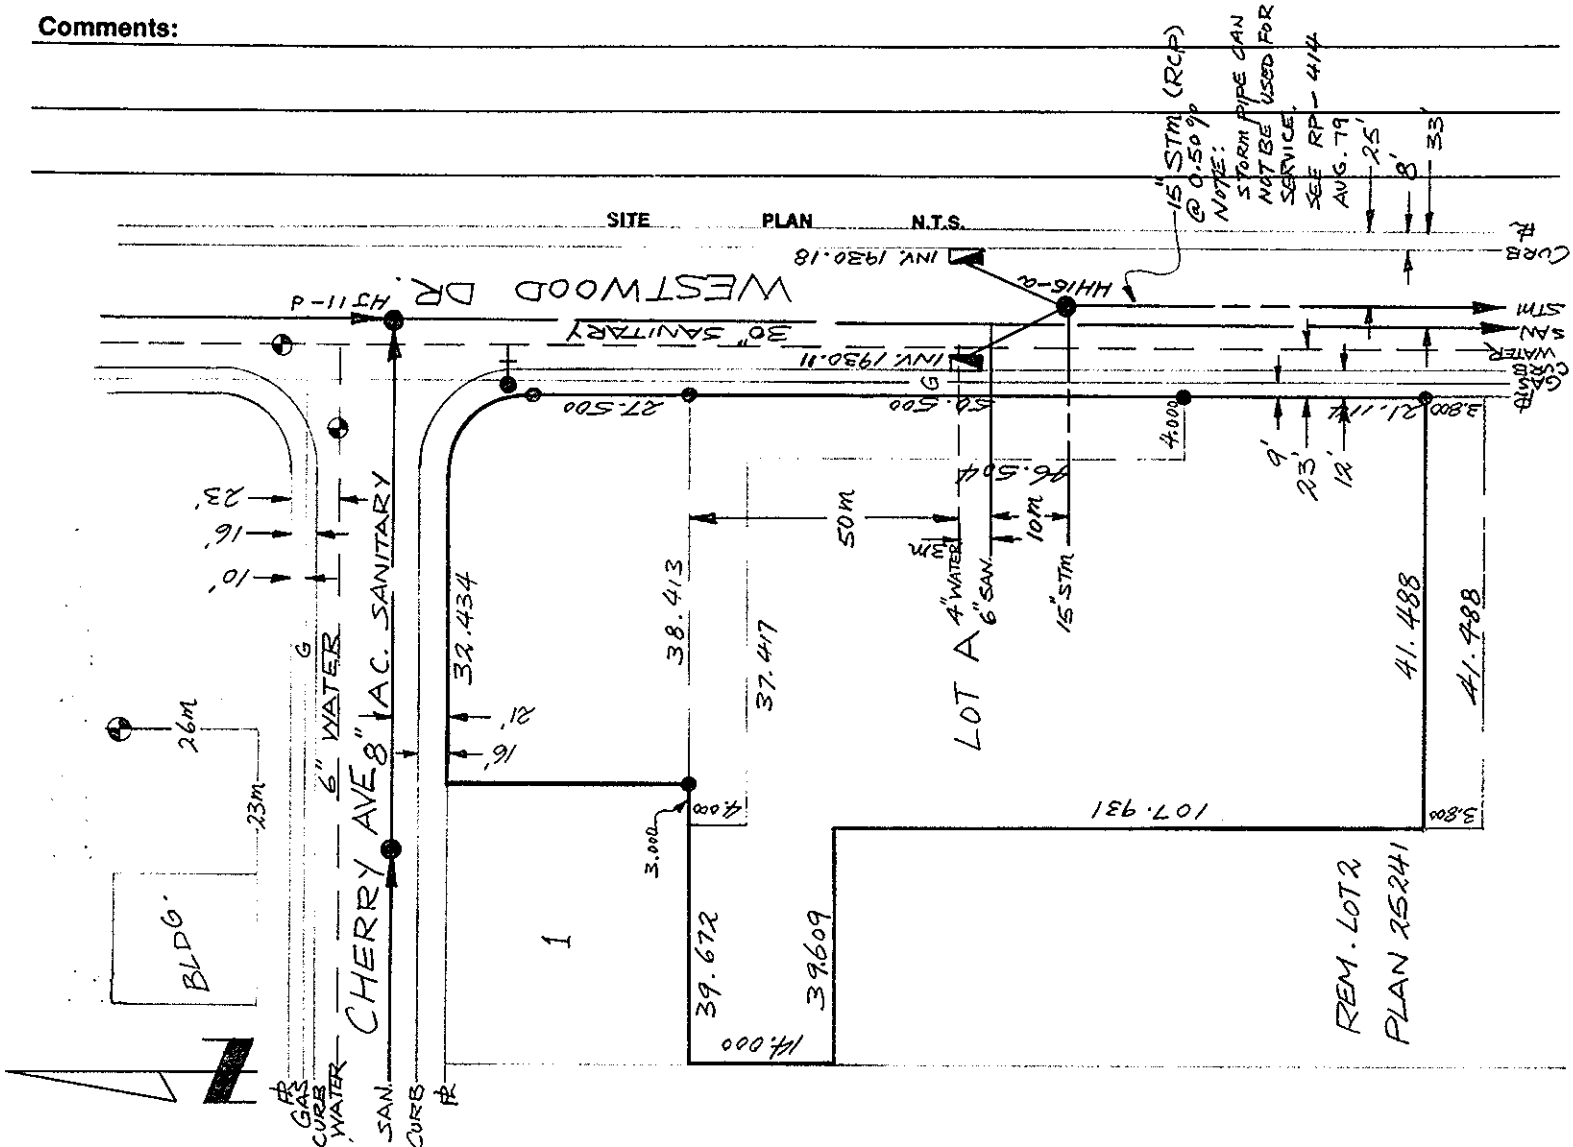
SITE PLAN N.T.S.