City of Prince George
HISTORY SHEET

SHEET NUMBER № 4576 **Roll Number** 00923377

Legal: LOT'S 13 BLOCK D.L. 4050 PLAN 26344

Address: 4962 MEADOWBROOK ROAD

Sanitary Connection: # SIZE 100ϕ MATERIAL PVC INV. 604.82 CONNECTED

Water Connection # SIZE 20ϕ MATERIAL Copper METER No CONNECTED

Storm Connection: # SIZE MATERIAL INV. CONNECTED

Cash Receipt No's: WATER SANITARY STORM

CURB FROM PROPERTY LINE 5.00 PAVEMENT WIDTH 10.00

B.C. HYDRO ⅊ 1.2 FROM PL UNDERGROUND CONNECTION U/G MID LOT

B.C. TELEPHONE ⅊ 1.5 FROM PL UNDERGROUND CONNECTION U/G MID LOT

INLAND GAS ⅊ 3.0 FROM PL

Information Sheets:

Comments: BENCH MARK - HYDRANT SPINDLE OPPOSITE FAIRBURN COURT - 608.075
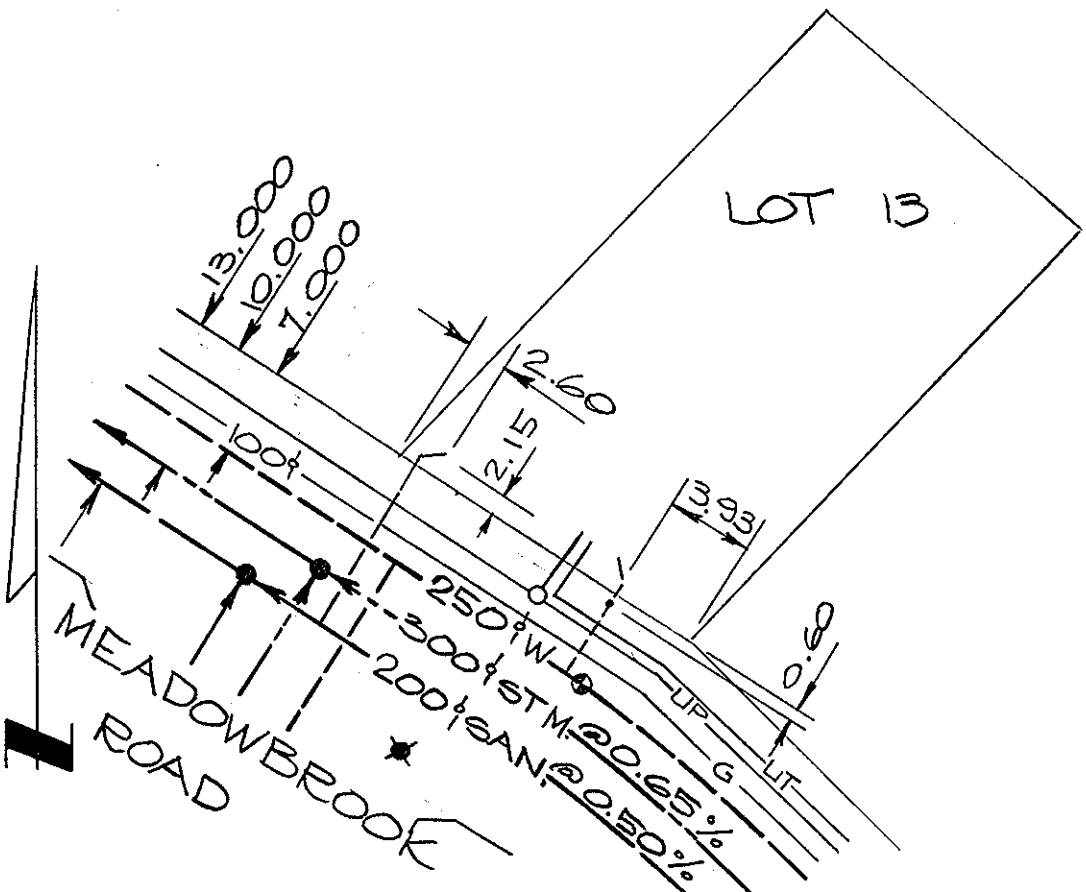
SITE PLAN N.T.S.