City of Prince George
HISTORY SHEET

00728256

SHEET NUMBER 11851 **Roll Number**

Legal: LOT'S 1 BLOCK D.L. 2440 PLAN 1338

Address: 287 ONGMAN RD

Sanitary Connection: # SIZE 100mm MATERIAL PVC INV. CONNECTED

Water Connection # SIZE MATERIAL METER CONNECTED

Storm Connection: # SIZE MATERIAL INV. CONNECTED

Cash Receipt No's: WATER SANITARY 21778. STORM

CURB FROM PROPERTY LINE PAVEMENT WIDTH

B.C. HYDRO O/H UNDERGROUND CONNECTION

B.C. TELEPHONE O/H UNDERGROUND CONNECTION

INLAND GAS 2.133 m FROM P/L.

Information Sheets:

Comments: The information contained herein is for internal use only. Not to be relied upon unless confirmed by site inspection and/or investigation.
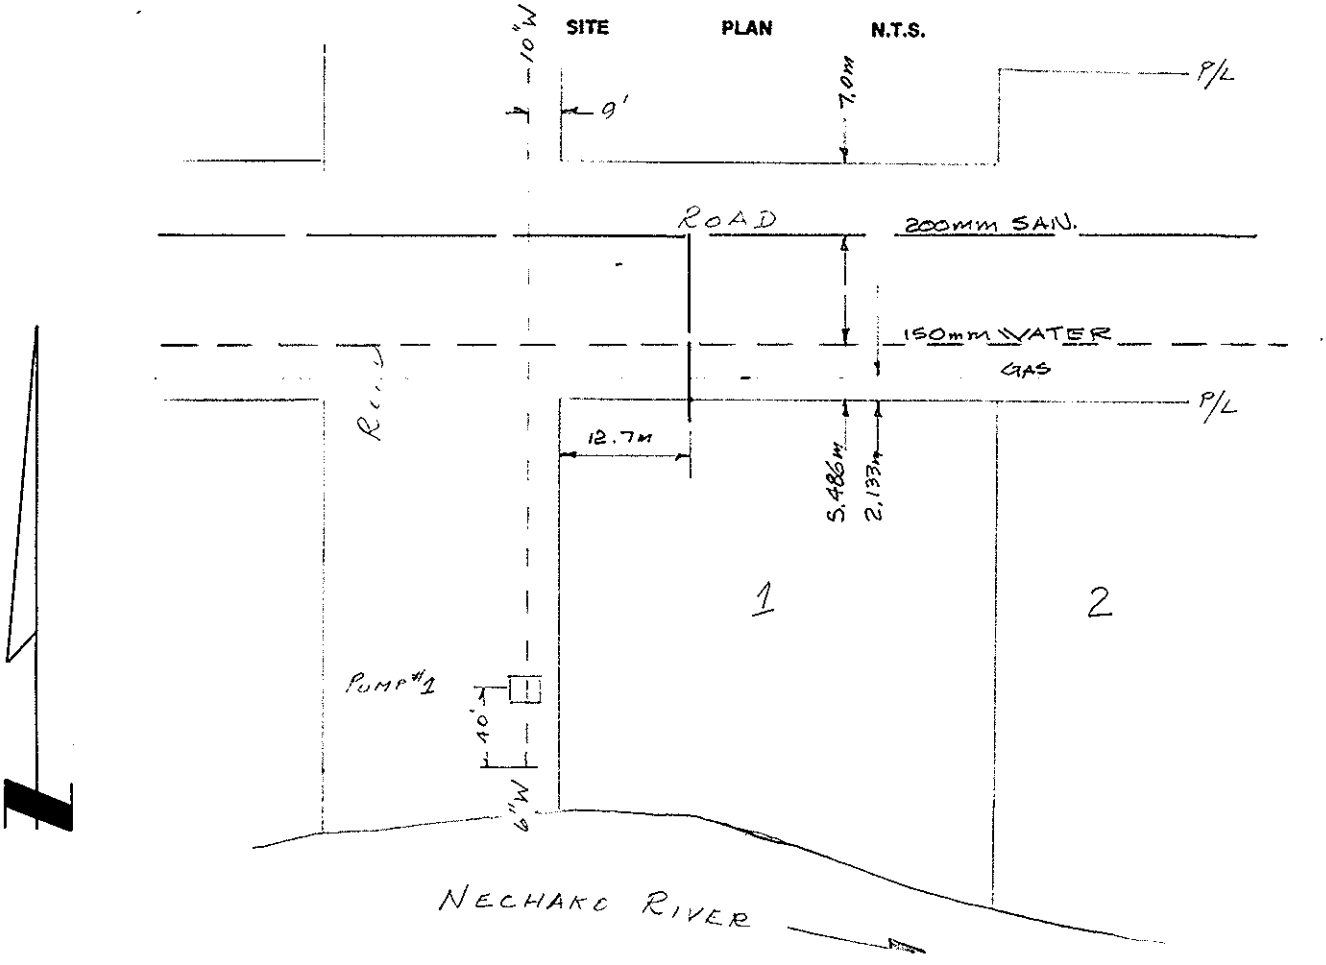
SITE PLAN N.T.S.