City of Prince George
HISTORY SHEET

009 283 041

SHEET NUMBER **Roll Number**

Legal: LOT'S [illegible] BLOCK 4 D.L. 960 PLAN 541

Address: 111 119 [illegible]

Sanitary Connection: # 4279 SIZE no info MATERIAL INV. CONNECTED

Water Connection # SIZE [illegible] MATERIAL [illegible] METER CONNECTED

Storm Connection: # SIZE MATERIAL INV. CONNECTED

Cash Receipt No's: WATER SANITARY STORM

CURB FROM PROPERTY LINE PAVEMENT WIDTH

B.C. HYDRO UNDERGROUND CONNECTION

B.C. TELEPHONE UNDERGROUND CONNECTION

INLAND GAS

Information Sheets:

Comments:
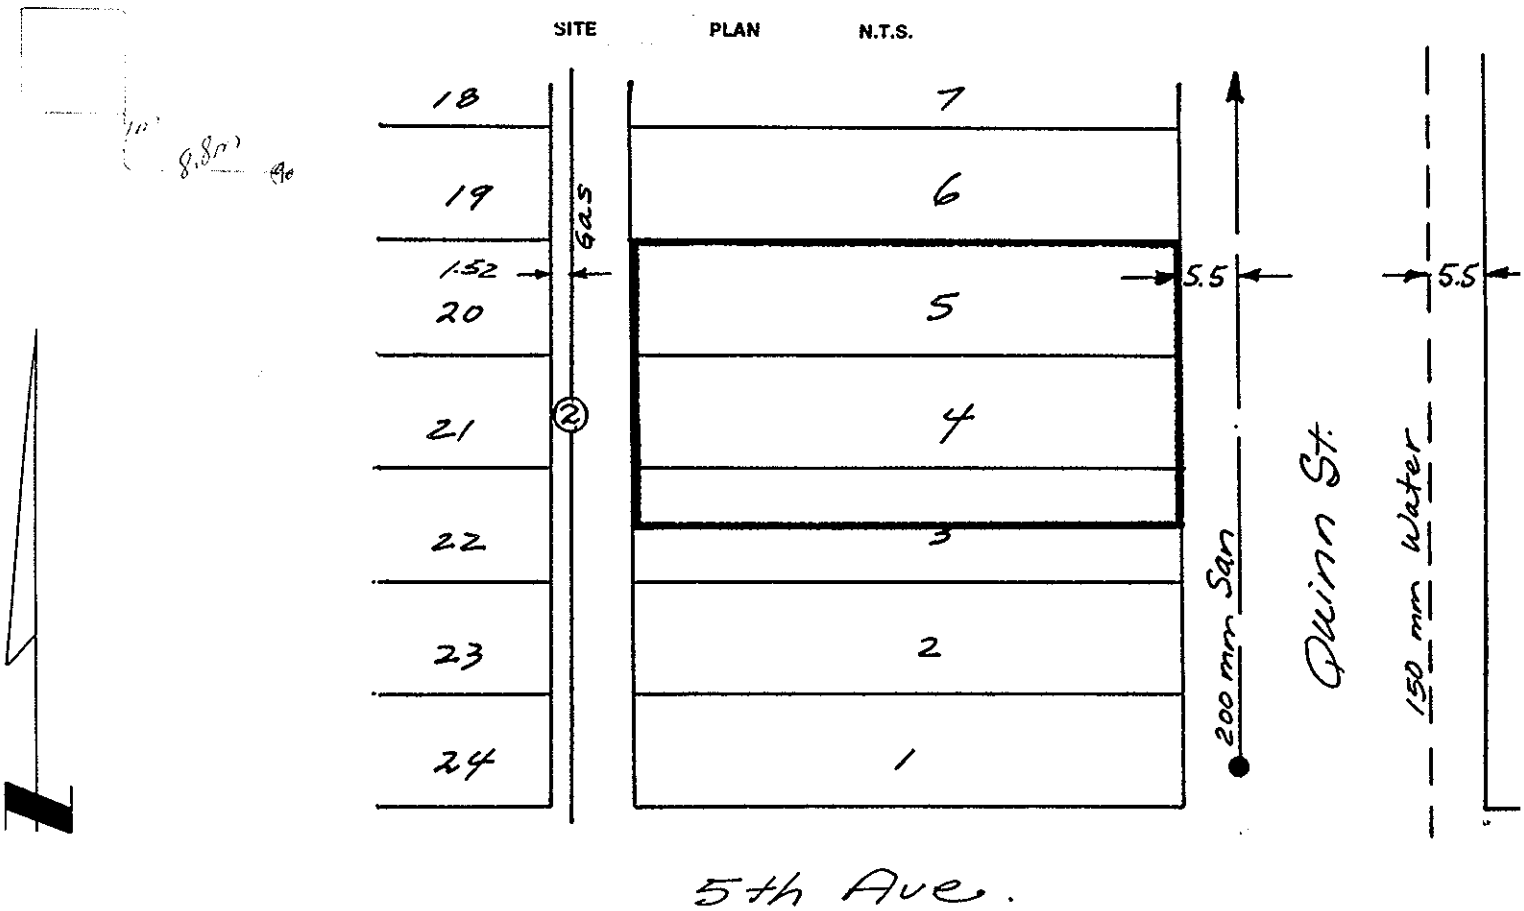
SITE PLAN N.T.S.