City of Prince George
HISTORY SHEET

007283474

SHEET NUMBER **4350** Roll Number

Legal: LOT'S **43** BLOCK D.L. **482** PLAN 22721

Address: 4780 1ST AVE OR 4807 ZIMMARO AVE.

Sanitary Connection: # SIZE 4" MATERIAL A.C. INV. 97.79 CONNECTED YES

Water Connection # SIZE 3/4" MATERIAL Co METER No CONNECTED YES

Storm Connection: # SIZE MATERIAL INV. CONNECTED

Cash Receipt No's: WATER SANITARY STORM

CURB FROM PROPERTY LINE PAVEMENT WIDTH

B.C. HYDRO UNDERGROUND CONNECTION

B.C. TELEPHONE UNDERGROUND CONNECTION

INLAND GAS

Information Sheets:

Comments: B.M. No. 1307-76.
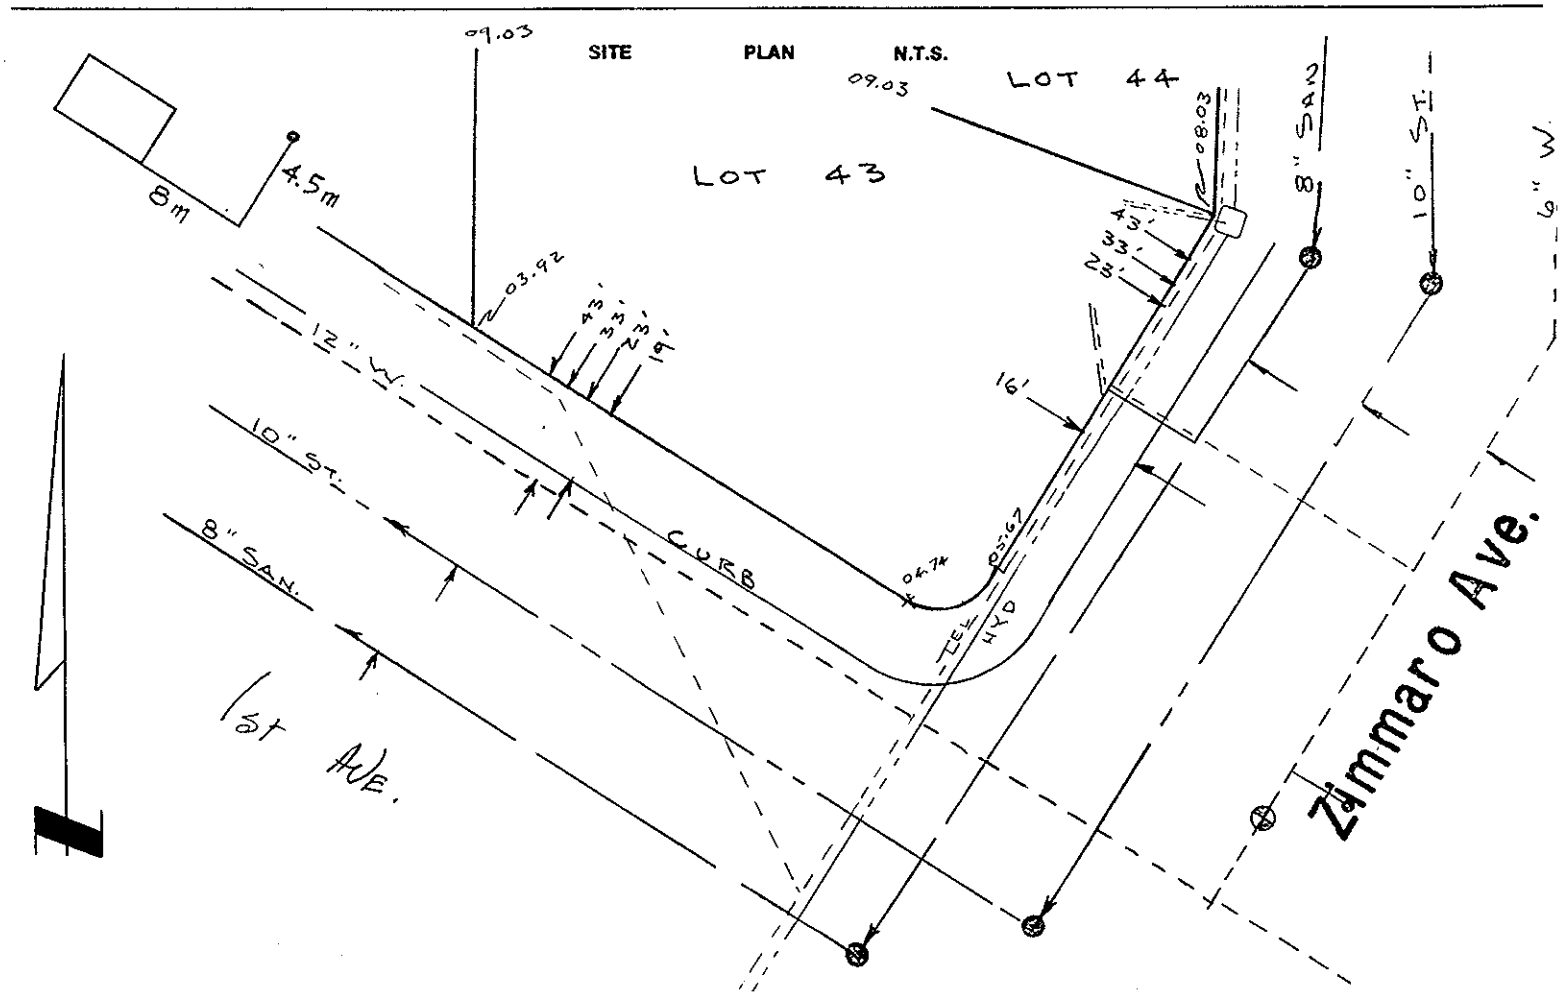
H.S. S.E. Cor. 1st. & Skinner. Elev. 2003.63