City of Prince George
HISTORY SHEET

SHEET NUMBER

Roll Number 0078955.000

Legal: LOT'S 8 BLOCK D.L. 482 PLAN 24318

Address: 122 SKINNER ST.

Sanitary Connection: # 11797 SIZE 4" MATERIAL A.C. INV. CONNECTED

Water Connection # 11797 SIZE 3/4" MATERIAL C.U. METER CONNECTED

Storm Connection: # SIZE MATERIAL INV. CONNECTED

Cash Receipt No's: WATER SANITARY STORM

CURB FROM PROPERTY LINE 16' (ROLL CURB) PAVEMENT WIDTH 34'

B.C. HYDRO UNDERGROUND CONNECTION

B.C. TELEPHONE UNDERGROUND CONNECTION

INLAND GAS

Information Sheets:

Comments: B.M. HYD. # 1307 S.E. CORNER 1st / SKINNER

2003.67
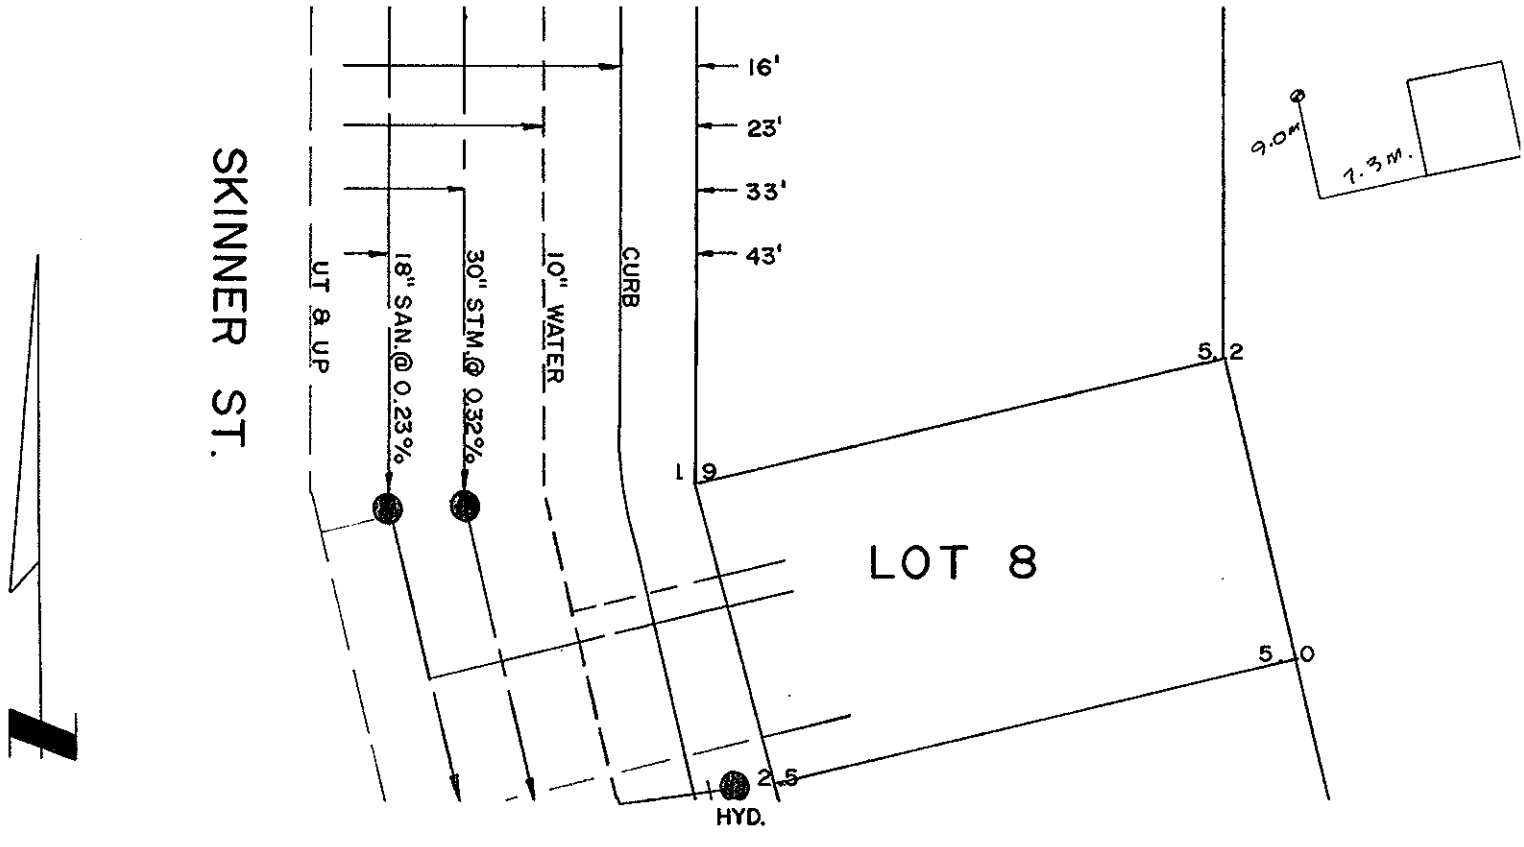
SITE PLAN N.T.S.