007327188 007327200
007327137 007327226
007327153 007327251
007327307, 007327170 007327285

City of Prince George
HISTORY SHEET

SHEET NUMBER **1009** **Roll Number** 2805-000

Legal: LOT'S 3-11 BLOCK 127 D.L. 343 PLAN 1268

Address: 1897 THIRD AVE PRINCE GEORGE, B.C. 1855 THIRD AVE.

Sanitary Connection: #* 2240 to 2243 SIZE MATERIAL INV. –, 96.33 CONNECTED –, –, –

Water Connection # 8876, 8877 (8876) SIZE 6", 6" MATERIAL AC 150 METER CONNECTED –

Storm Connection: # 414 SIZE 8" MATERIAL INV. 00.73 CONNECTED –

Cash Receipt No's: WATER 226 SANITARY –, – STORM 227

CURB FROM PROPERTY LINE – PAVEMENT WIDTH –

B.C. HYDRO O.H UNDERGROUND CONNECTION –

B.C. TELEPHONE O.H UNDERGROUND CONNECTION –

INLAND GAS IN LANE 2" ϕ MAIN.

Information Sheets: 1991

Comments:
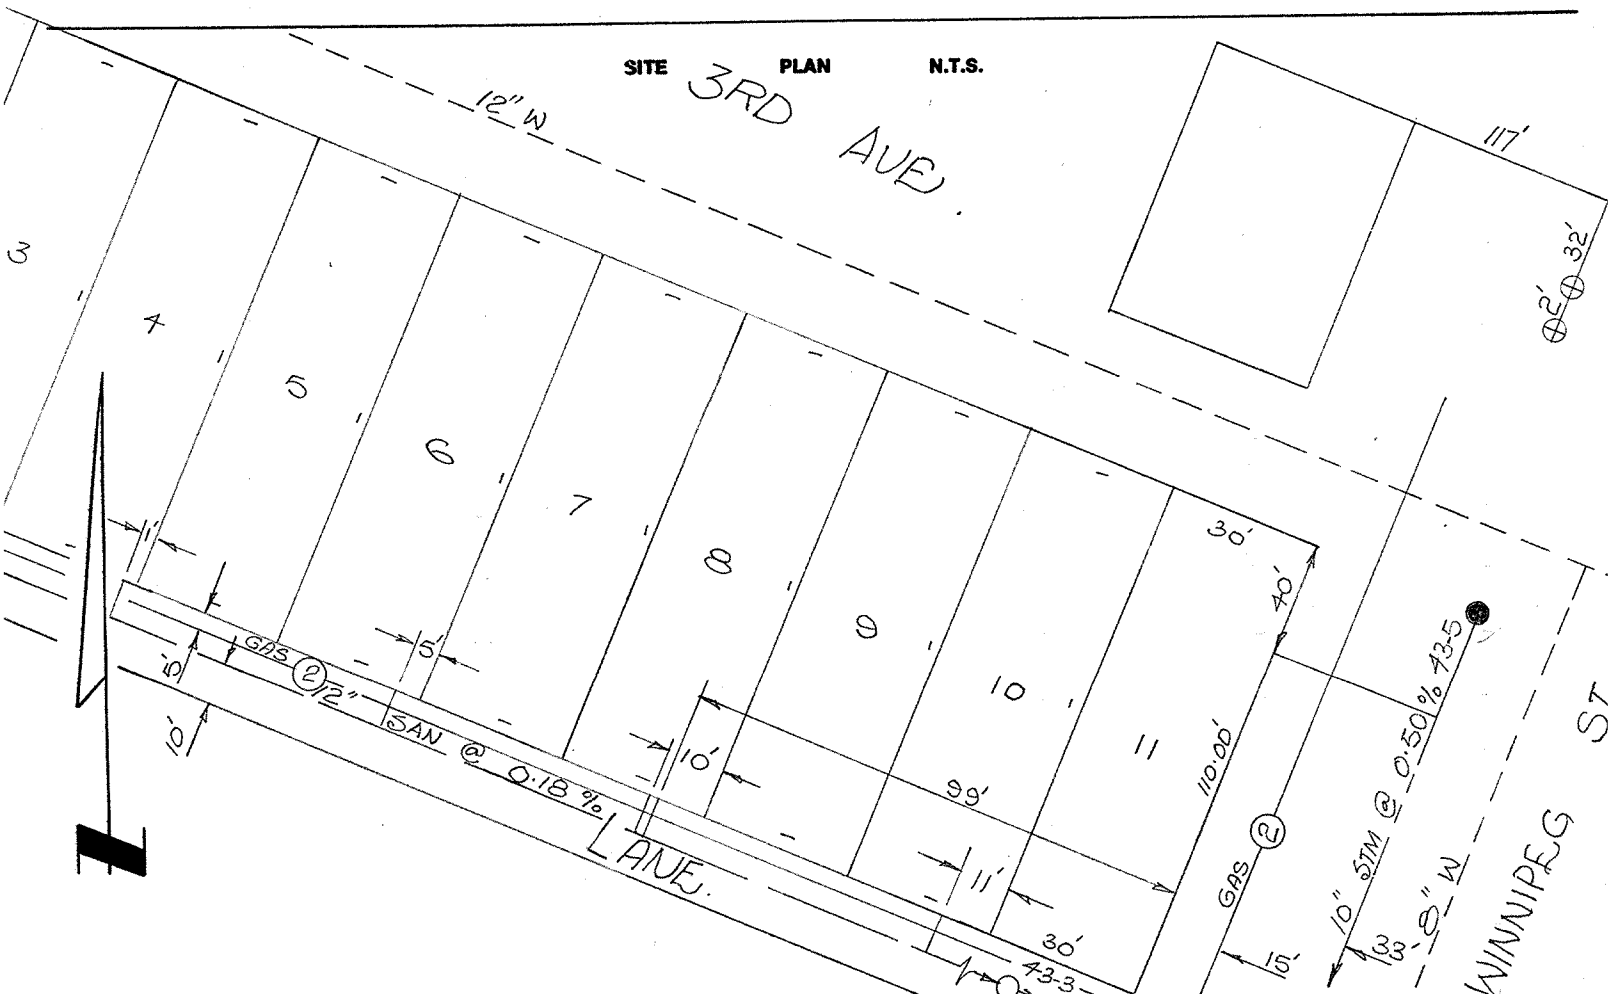
SITE PLAN N.T.S.