007329890
007329920
007329954
007329971

City of Prince George
HISTORY SHEET

SHEET NUMBER 838 **Roll Number** 2415-000

Legal: LOT'S 1-4 BLOCK 115 D.L. 343 PLAN 1268

Address: 2410 ROSS CR. PRINCE GEORGE, B.C. 2410 ROSS CR.

Sanitary Connection: # 6625 SIZE – MATERIAL – INV. 1907.44 CONNECTED –

Water Connection # 6994 SIZE 3/4" MATERIAL Copper METER CONNECTED –

Storm Connection: # – SIZE MATERIAL INV. CONNECTED –

Cash Receipt No's: WATER SANITARY 31 STORM

CURB FROM PROPERTY LINE 22' PAVEMENT WIDTH 36'

B.C. HYDRO O.H UNDERGROUND CONNECTION –

B.C. TELEPHONE IN ROSS CR U.T. 63 UNDERGROUND CONNECTION –

INLAND GAS IN ROSS CR. 2" ϕ MAIN. & IN LANE TOO.

Information Sheets: –
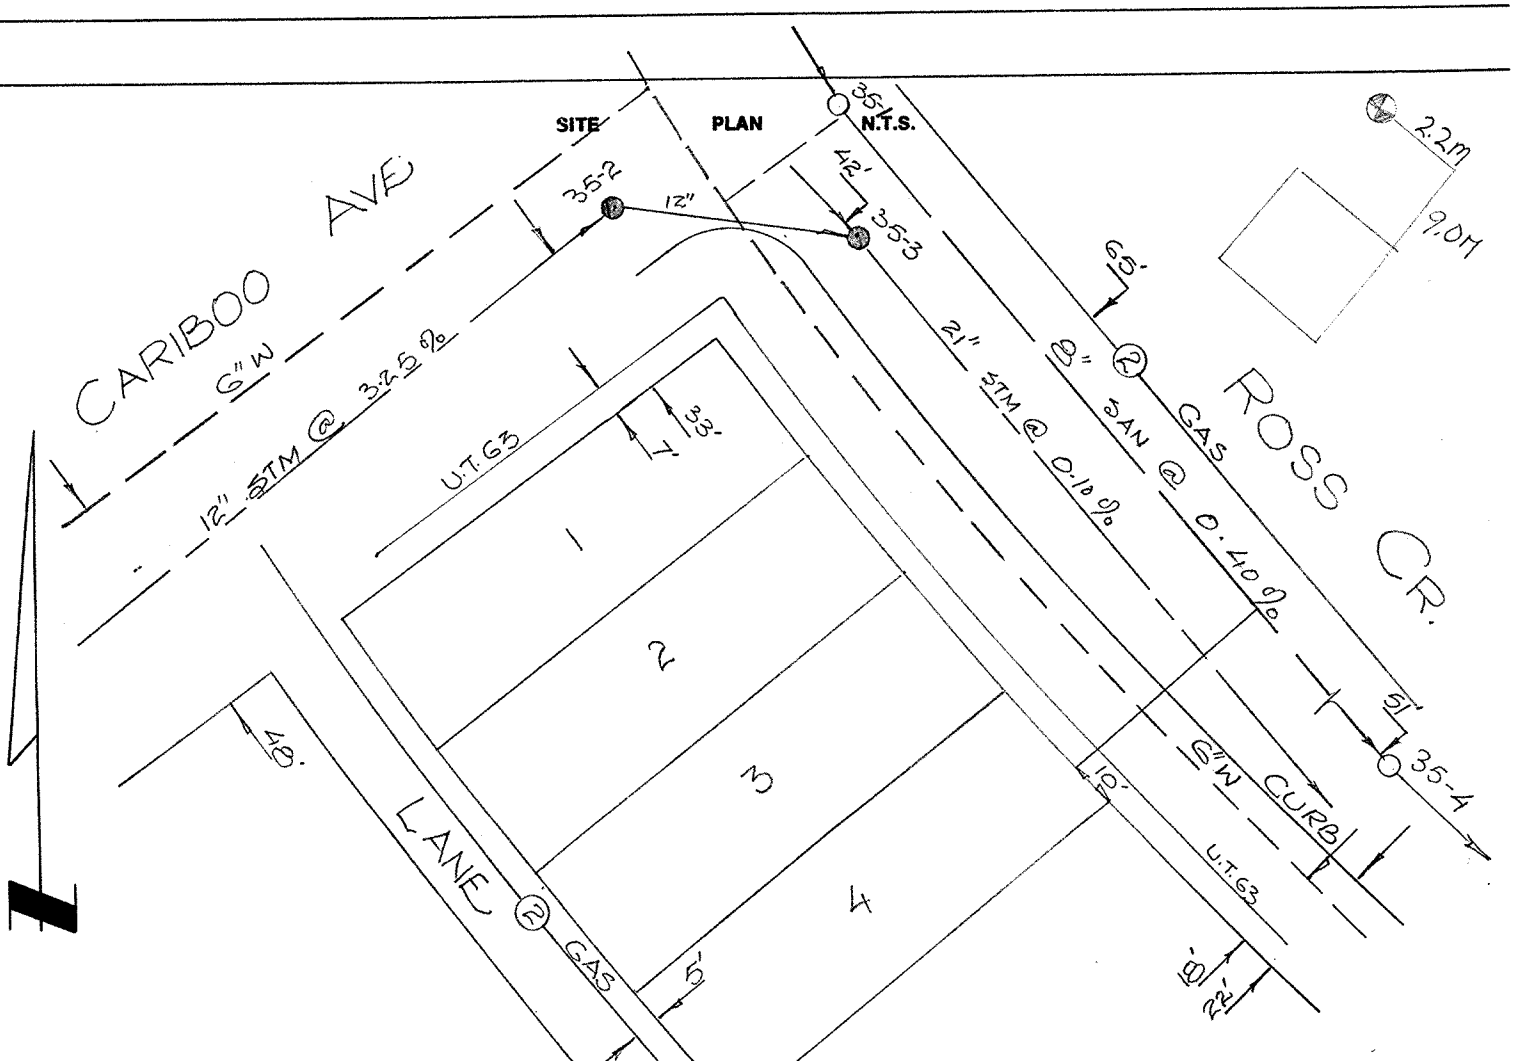
Comments: