City of Prince George
HISTORY SHEET

007353481

SHEET NUMBER 5491 **Roll Number**

Legal: LOT'S 29 BLOCK D.L. 4046 PLAN 26060

Address: 2626 CARLISLE WAY

Sanitary Connection: # SIZE 100 mm MATERIAL PVC INV. 735.01 CONNECTED

Water Connection # SIZE 18 mm MATERIAL COPPER METER CONNECTED

Storm Connection: # NONE SIZE MATERIAL INV. CONNECTED

Cash Receipt No's: WATER SANITARY STORM

CURB FROM PROPERTY LINE OPEN DITCH PAVEMENT WIDTH 8 m

B.C. HYDRO UNDERGROUND CONNECTION

B.C. TELEPHONE UNDERGROUND CONNECTION

INLAND GAS

Information Sheets:

Comments: BM: HYD SPINDLE N/W COR NIXON & RIDGEVIEW DR.
ELEV. 743.712 M
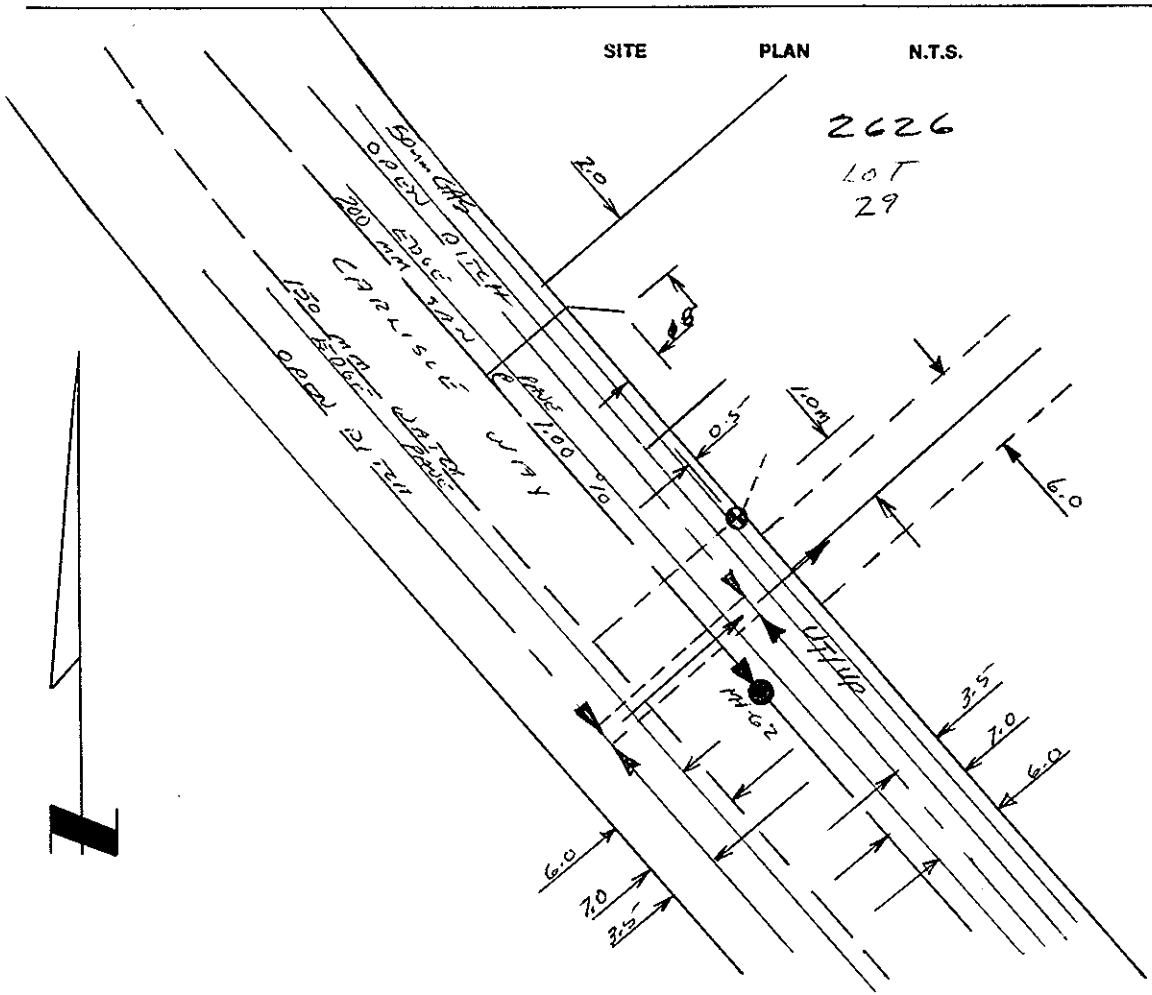
SITE PLAN N.T.S.