City of Prince George
HISTORY SHEET

0074671184

SHEET NUMBER № 2634 **Roll Number**

Legal: LOT'S 2 BLOCK D.L. 751 PLAN 25912

Address: ROCK ISLAND - PENN RD.

Sanitary Connection: # SIZE MATERIAL INV. CONNECTED

Water Connection # SIZE MATERIAL METER CONNECTED

Storm Connection: # SIZE MATERIAL INV. CONNECTED

Cash Receipt No's: WATER SANITARY STORM

CURB FROM PROPERTY LINE PAVEMENT WIDTH

B.C. HYDRO OVERHEAD UNDERGROUND CONNECTION

B.C. TELEPHONE OVERHEAD UNDERGROUND CONNECTION

INLAND GAS 4" GAS

Information Sheets:

Comments:
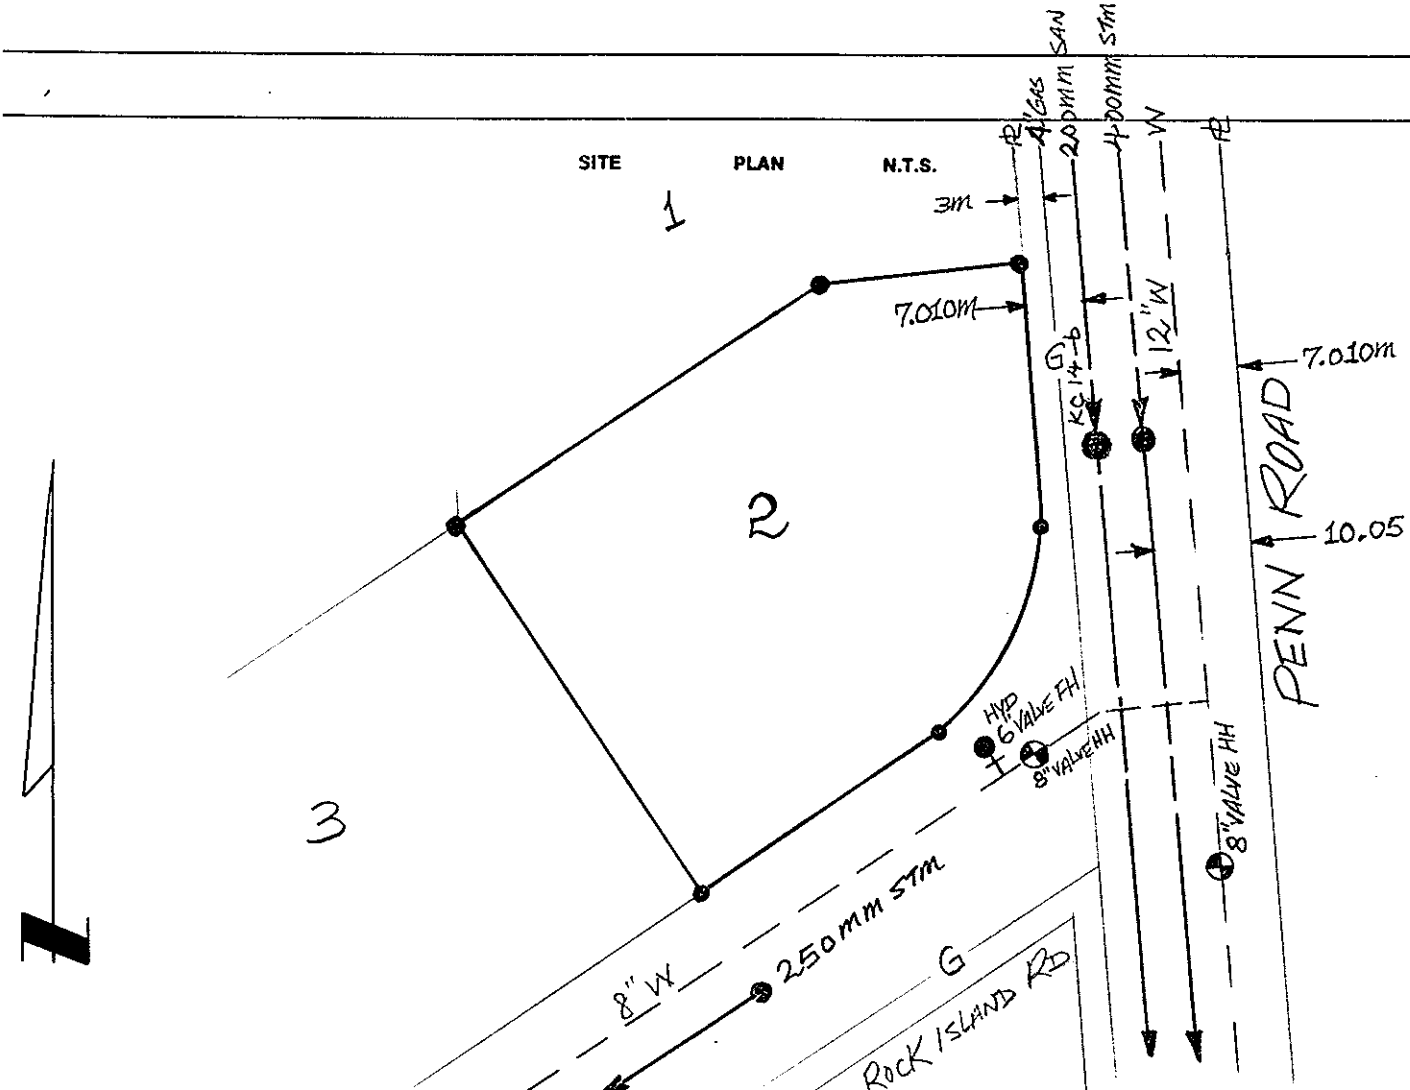
SITE PLAN N.T.S.