City of Prince George
HISTORY SHEET

D S
007543859

SHEET NUMBER **3210** **Roll Number**

Legal: LOT'S B BLOCK D.L. 4046 PLAN 25766

Address: 5747 LEHMANN RD.

Sanitary Connection: # 12660 SIZE 4" MATERIAL PVC INV. CONNECTED

Water Connection # 12660 SIZE 3/4" MATERIAL METER CONNECTED

Storm Connection: # SIZE MATERIAL INV. CONNECTED

Cash Receipt No's: WATER SANITARY STORM

CURB FROM PROPERTY LINE PAVEMENT WIDTH

B.C. HYDRO O.H. UNDERGROUND CONNECTION

B.C. TELEPHONE O.H. UNDERGROUND CONNECTION

INLAND GAS

Information Sheets:

Comments:
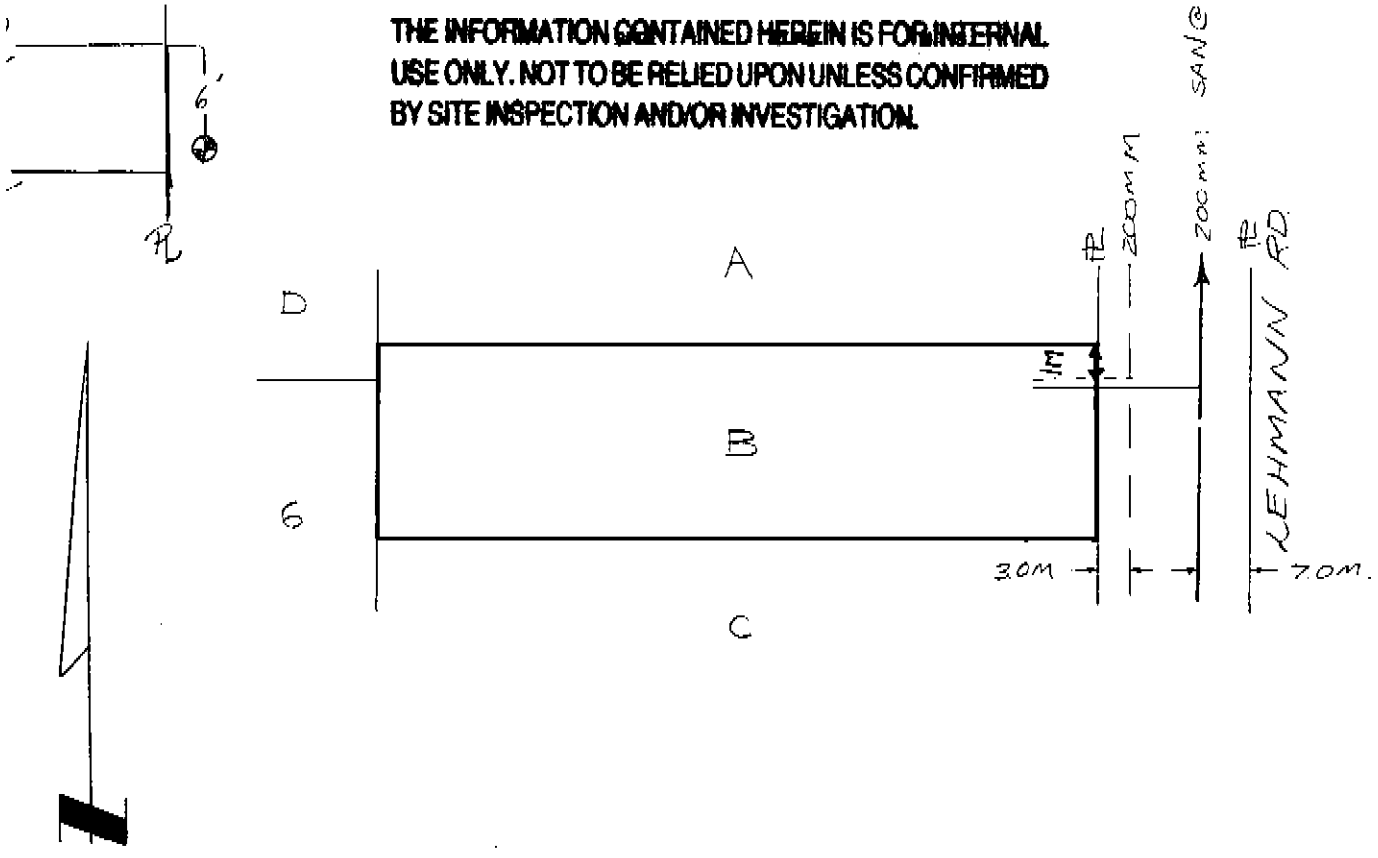
THE INFORMATION CONTAINED HEREIN IS FOR INTERNAL USE ONLY. NOT TO BE RELIED UPON UNLESS CONFIRMED BY SITE INSPECTION AND/OR INVESTIGATION.