City of Prince George
HISTORY SHEET

SHEET NUMBER № 4059 **Roll Number** 007-558-350

Legal: LOT'S 1 BLOCK D.L. 4050 PLAN 25854

Address: N. NECHAKO RD

Sanitary Connection: # SIZE MATERIAL INV. CONNECTED

Water Connection # SIZE MATERIAL METER CONNECTED

Storm Connection: # SIZE MATERIAL INV. CONNECTED

Cash Receipt No's: WATER SANITARY STORM

CURB FROM PROPERTY LINE PAVEMENT WIDTH

B.C. HYDRO UNDERGROUND CONNECTION

B.C. TELEPHONE UNDERGROUND CONNECTION

INLAND GAS

THE INFORMATION CONTAINED HEREIN IS FOR INTERN/
USE ONLY. NOT TO BE RELIED UPON UNLESS CONFIRME
BY SITE INSPECTION AND/OR INVESTIGATION.

Information Sheets:
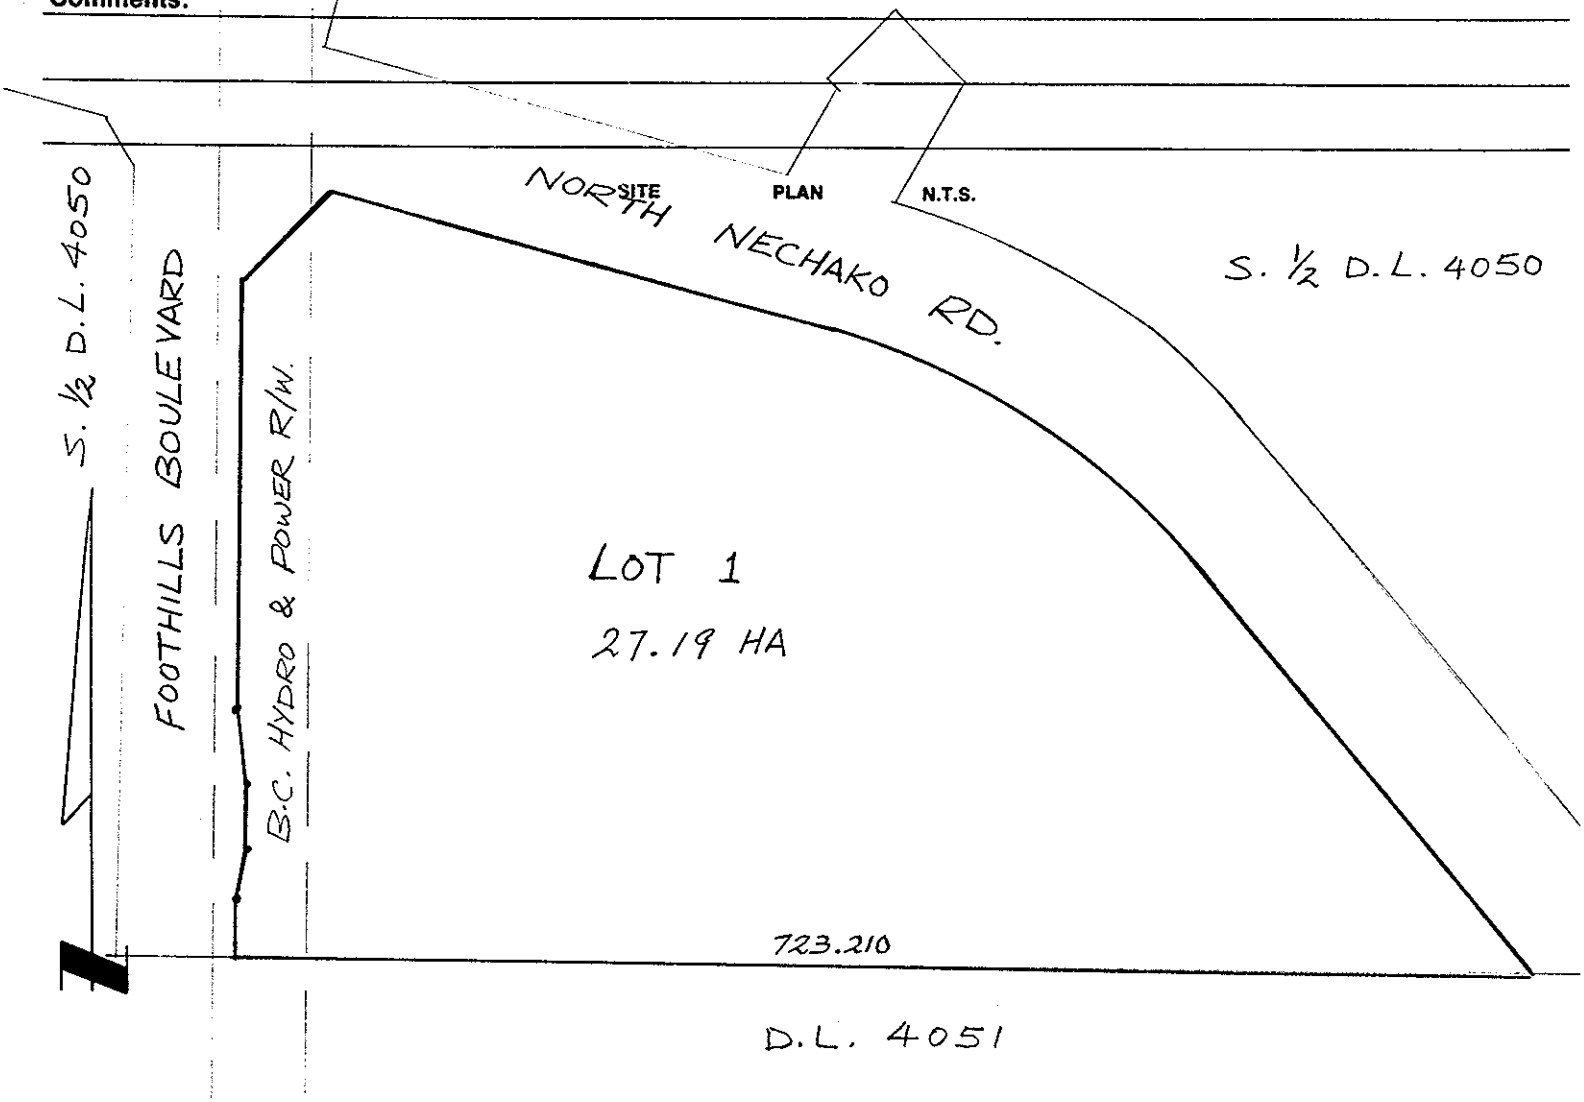
Comments: