City of Prince George
HISTORY SHEET

SHEET NUMBER **Roll Number** 007563281

Legal: LOT'S 21 BLOCK D.L. 8174 PLAN 25470

Address: 3678 PINEWOOD AVE.

Sanitary Connection: # SIZE 100mm MATERIAL INV. CONNECTED

Water Connection # SIZE 20mm MATERIAL METER CONNECTED

Storm Connection: # SIZE MATERIAL INV. CONNECTED

Cash Receipt No's: WATER SANITARY STORM

CURB FROM PROPERTY LINE 3.7M PAVEMENT WIDTH 12.8M

B.C. HYDRO U.G. O/S 0.91M FROM ℄. UNDERGROUND CONNECTION

B.C. TELEPHONE " " UNDERGROUND CONNECTION

INLAND GAS AS SHOWN.

Information Sheets:

Comments:

THE INFORMATION CONTAINED HEREIN IS FOR INTERNAL USE ONLY. NOT TO BE RELIED UPON UNLESS CONFIRMED BY SITE INSPECTION AND/OR INVESTIGATION.

SITE PLAN N.T.S.

RE: ENG DWG ~~2387~~. 3245.25
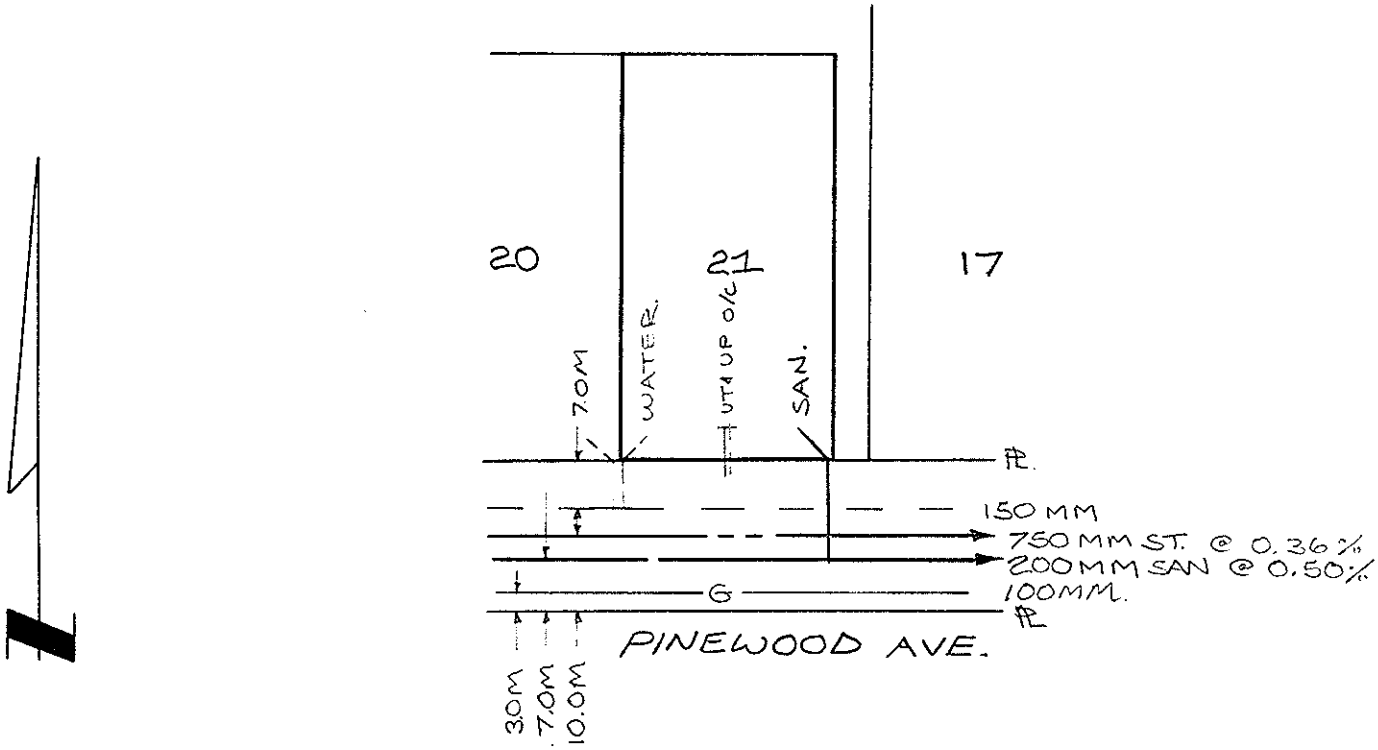
18