City of Prince George
HISTORY SHEET

55'
561

SHEET NUMBER **5013** **Roll Number**

Legal: LOT'S A, 11, & 12 BLOCK 246 D.L. 343 PLAN 1268

Address: 1598 CEDAR ST.

Sanitary Connection: # 2591 SIZE MATERIAL INV. CONNECTED

Water Connection # 2393 SIZE 20mm MATERIAL CU. METER CONNECTED

Storm Connection: # SIZE MATERIAL INV. CONNECTED

Cash Receipt No's: WATER SANITARY STORM

CURB FROM PROPERTY LINE 16' PAVEMENT WIDTH 34'

B.C. HYDRO O.H. UNDERGROUND CONNECTION

B.C. TELEPHONE O.H. UNDERGROUND CONNECTION

INLAND GAS AS SHOWN.

Information Sheets:
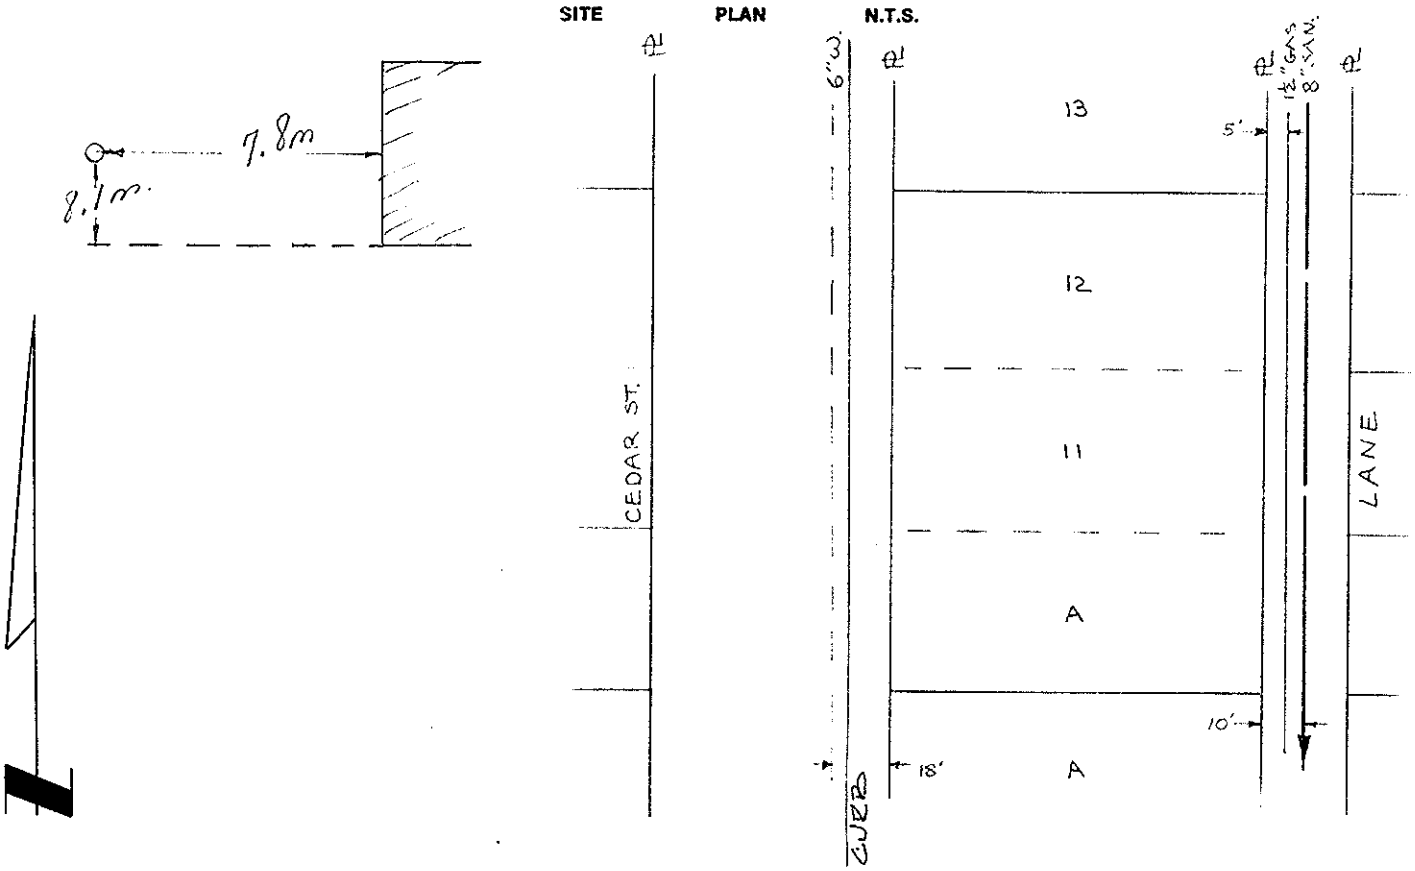
Comments: