10

City of Prince George
HISTORY SHEET

SHEET NUMBER 3478 Roll Number 007557698

Legal: LOT'S 10 BLOCK D.L. 4046 PLAN 25847

Address: 2084 Croft. Rd.

Sanitary Connection: # SIZE 100mm MATERIAL P.V.C. INV. 7/7.68 CONNECTED

Water Connection # SIZE 19mm MATERIAL Copper METER CONNECTED

Storm Connection: # SIZE MATERIAL INV. CONNECTED

Cash Receipt No's: WATER SANITARY STORM

CURB FROM PROPERTY LINE Ditch PAVEMENT WIDTH — 8m

B.C. HYDRO OH UNDERGROUND CONNECTION

B.C. TELEPHONE OH UNDERGROUND CONNECTION

INLAND GAS 2" Gas on top of water main

Information Sheets:

Comments: B.M. Hyd. sp. N.W. cor. Croft & Oakridge 727.081 City #1979-79

THE INFORMATION CONTAINED HEREIN IS FOR INTERNAL USE ONLY. NOT TO BE RELIED UPON UNLESS CONFIRMED BY SITE INSPECTION AND/OR INVESTIGATION.
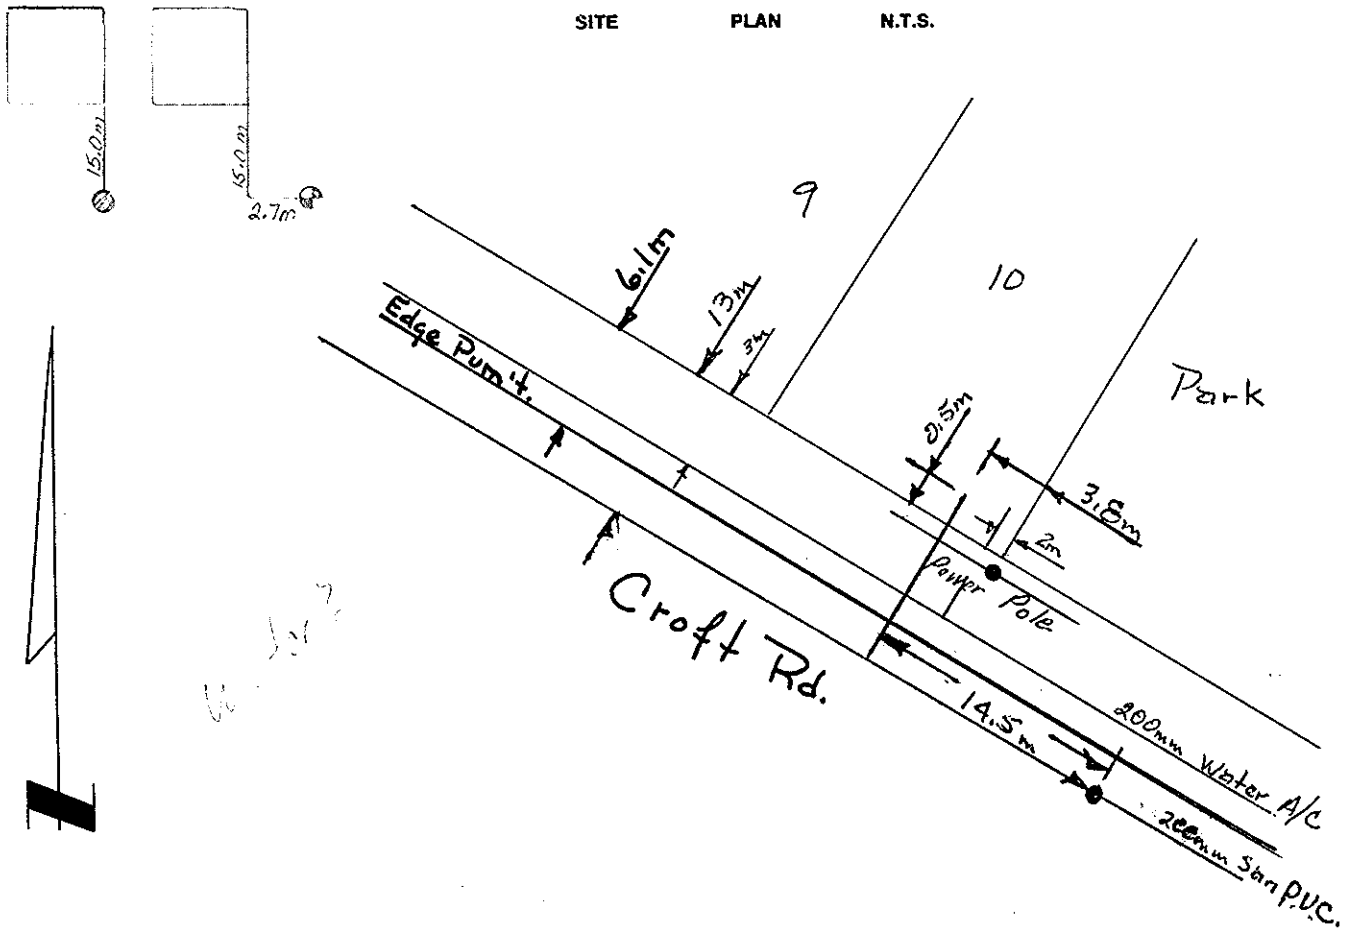
SITE PLAN N.T.S.