City of Prince George
HISTORY SHEET

007708076
007708106

SHEET NUMBER 987 **Roll Number** 2758-000

Legal: LOT'S 14-15-16 BLOCK 125 D.L. 343 PLAN 1268

Address: 2087 LAURIER CR. PRINCE GEORGE, B.C. 2087 LAURIER CR.

Sanitary Connection: # 598 SIZE MATERIAL INV. 1920.15 CONNECTED YES.

Water Connection # 226 SIZE 1/2" MATERIAL Cu METER – CONNECTED –

Storm Connection: # SIZE MATERIAL INV. CONNECTED

Cash Receipt No's: WATER – SANITARY 1423 STORM

CURB FROM PROPERTY LINE 16' PAVEMENT WIDTH 34'

B.C. HYDRO O.H UNDERGROUND CONNECTION –

B.C. TELEPHONE IN MELVILLE ST U.T. 21 UNDERGROUND CONNECTION –

INLAND GAS IN LANE 2" ϕ MAIN.

Information Sheets: 15

Comments:
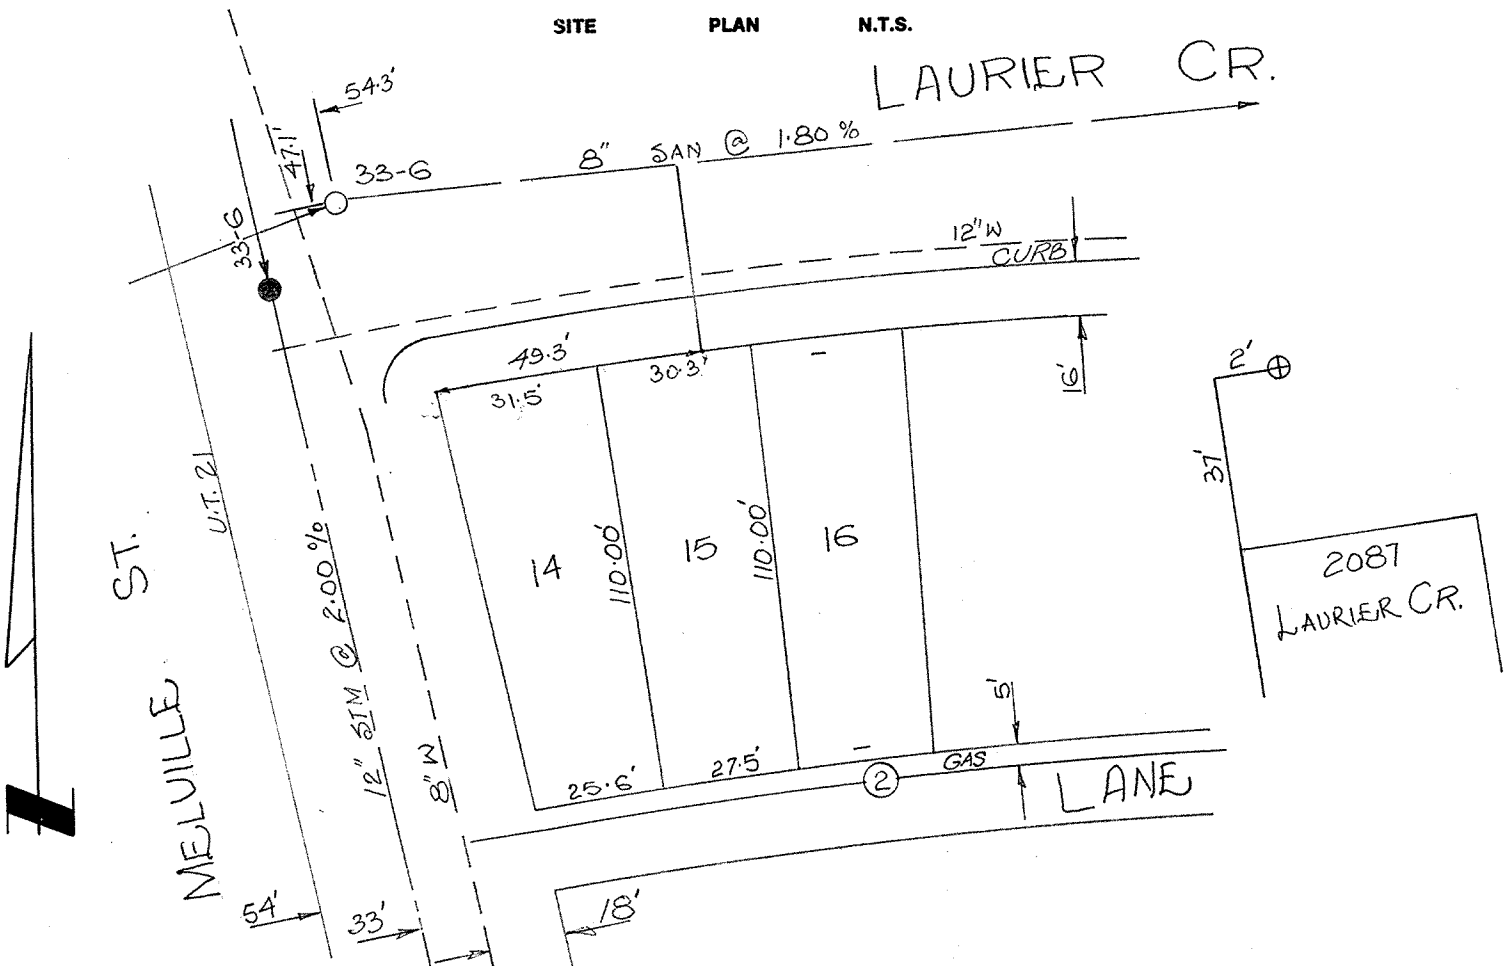
SITE PLAN N.T.S.