City of Prince George
HISTORY SHEET

0077741103 0077741138
0077741111 0077741146
0077741120

SHEET NUMBER 1014 **Roll Number** 2829-000

Legal: LOT'S 5-8 & W½ 9 BLOCK 128 D.L. 343 PLAN 1268

Address: 1717 THIRD AVE PRINCE GEORGE, B.C. 1717 THIRD AVE.

Sanitary Connection: # 3362 SIZE - MATERIAL - INV. 1894.25 CONNECTED YES.

Water Connection # 3362 SIZE 1½" MATERIAL Cu METER - CONNECTED YES.

Storm Connection: # - SIZE MATERIAL INV. CONNECTED

Cash Receipt No's: WATER - SANITARY 1295 STORM

CURB FROM PROPERTY LINE 10' PAVEMENT WIDTH -

B.C. HYDRO O·H UNDERGROUND CONNECTION -

B.C. TELEPHONE O·H UNDERGROUND CONNECTION -

INLAND GAS IN LANE 2" ϕ MAIN.

Information Sheets: -

Comments:
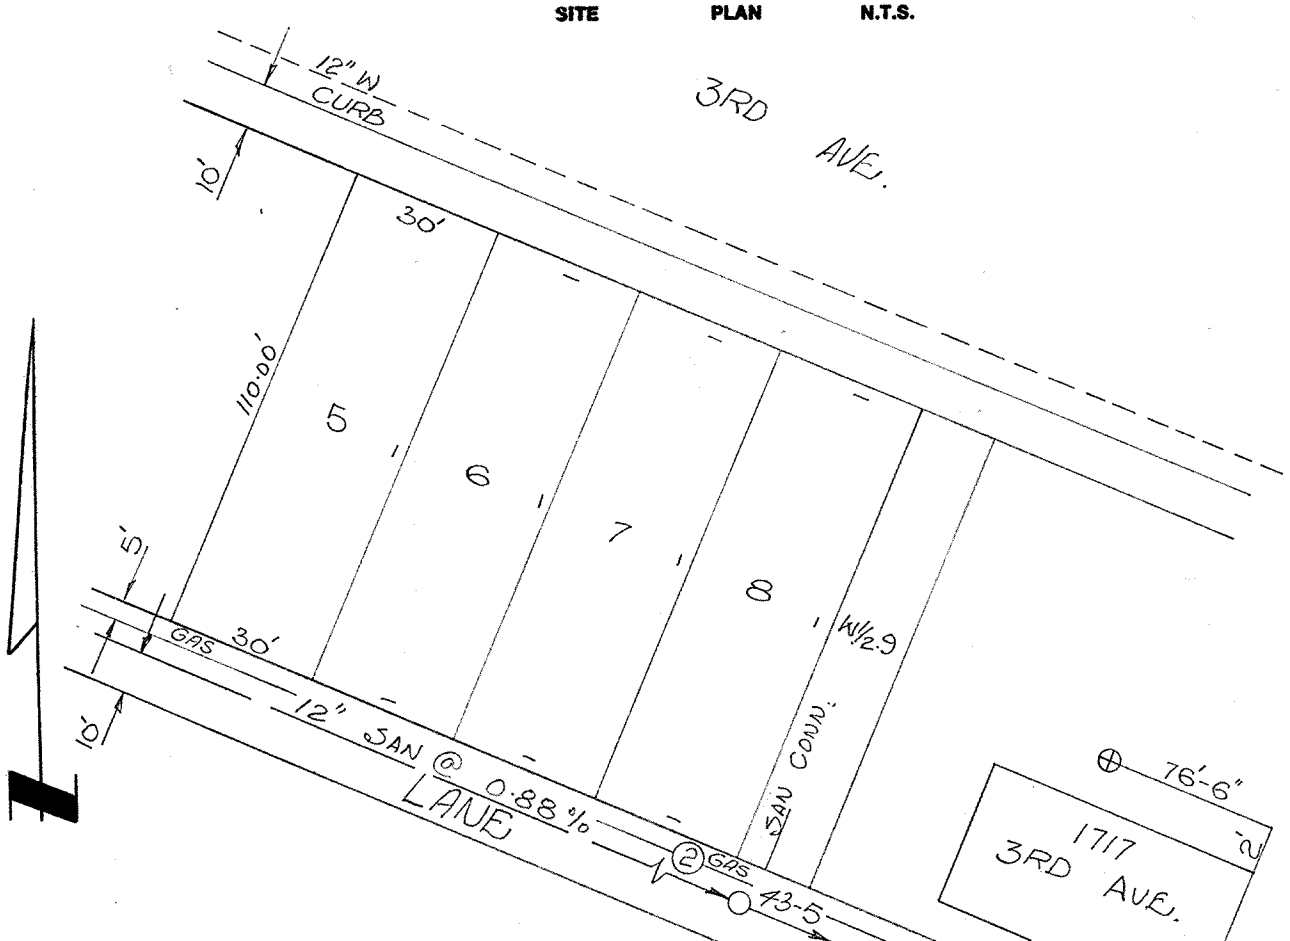
SITE PLAN N.T.S.