00443335
343

City of Prince George
HISTORY SHEET

SHEET NUMBER № 4755 **Roll Number**

Legal: LOT'S 7-8 BLOCK 1 D.L. 937 PLAN 752

Address: 737 CARNEY STREET

Sanitary Connection: # 961 SIZE MATERIAL INV. CONNECTED

Water Connection # 900 SIZE 3/4" MATERIAL COPPER METER CONNECTED

Storm Connection: # SIZE MATERIAL INV. CONNECTED

Cash Receipt No's: WATER SANITARY STORM

CURB FROM PROPERTY LINE 12' PAVEMENT WIDTH 42'

B.C. HYDRO OVERHEAD UNDERGROUND CONNECTION

B.C. TELEPHONE UNDERGROUND CONNECTION

INLAND GAS

Information Sheets:

Comments:
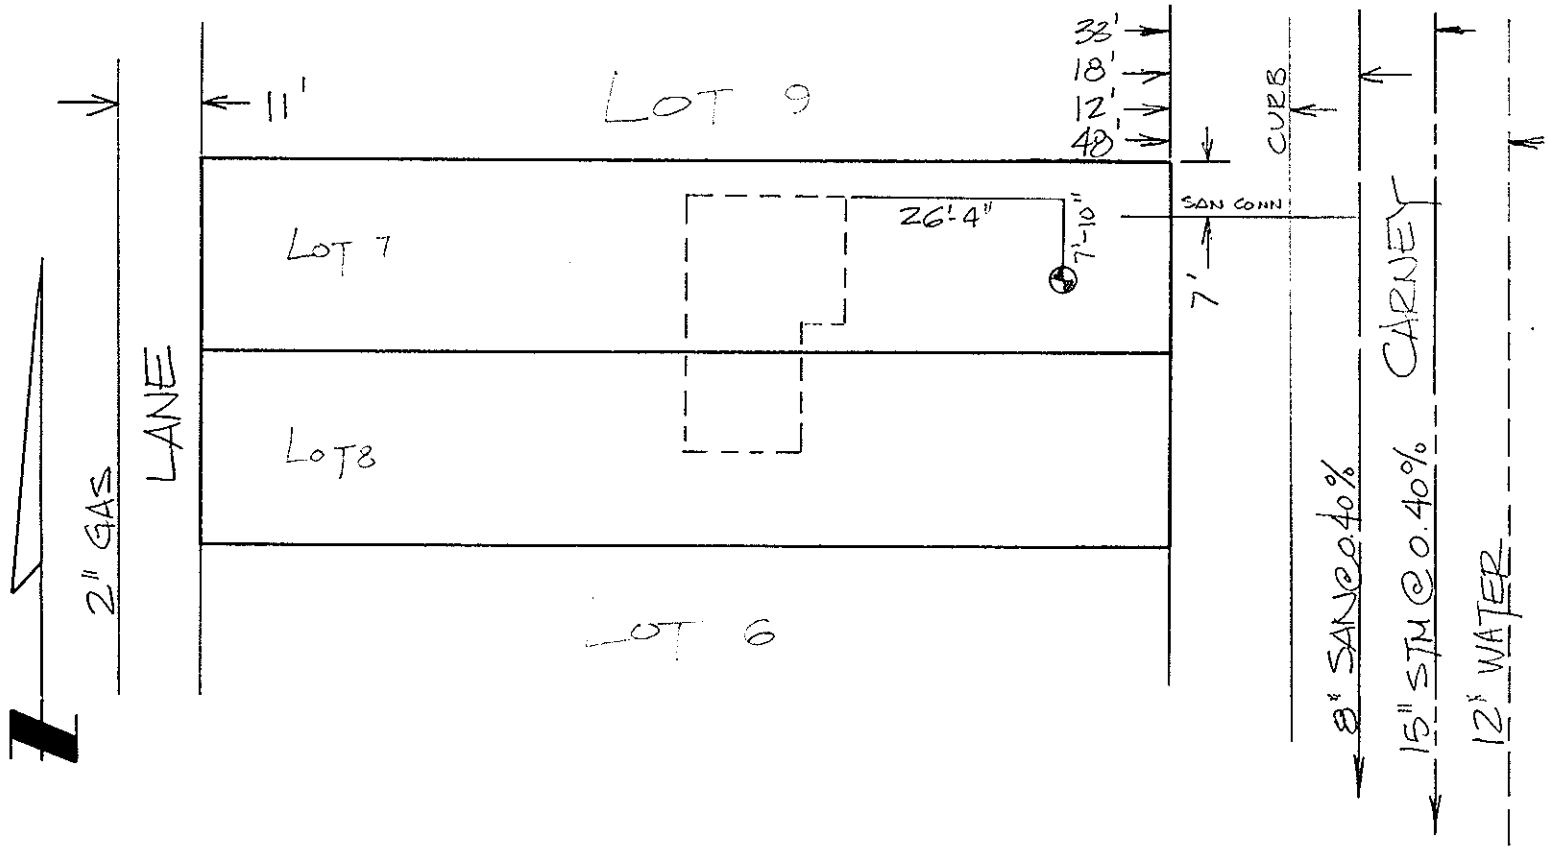
SITE PLAN N.T.S.