City of Prince George
HISTORY SHEET

PREPARED BY
ASSOCIATED ENGINEERING SERVICES LTD.

SHEET NUMBER 5565 **Roll Number** 007746075

Legal: LOT'S 59 BLOCK SE 1/4 D.L. 4046 PLAN 25412

Address: 2538 RIDGEVIEW DRIVE

Sanitary Connection: # SIZE 100 mm MATERIAL PVC INV. 32.53 CONNECTED

Water Connection # SIZE 20 mm MATERIAL COPPER METER NONE CONNECTED

Storm Connection: # NONE SIZE MATERIAL INV. CONNECTED

Cash Receipt No's: WATER SANITARY STORM

CURB FROM PROPERTY LINE OPEN DITCH PAVEMENT WIDTH 10.0 m

B.C. HYDRO UNDERGROUND CONNECTION U/G - MIDLOT

B.C. TELEPHONE UNDERGROUND CONNECTION U/G - MIDLOT

INLAND GAS 1.0 m OFFSET

Information Sheets:

Comments: B.M. - HYD. SPINDLE N.E. CORNER NIXON & RIDGEVIEW
ELEV. = 743.712 m
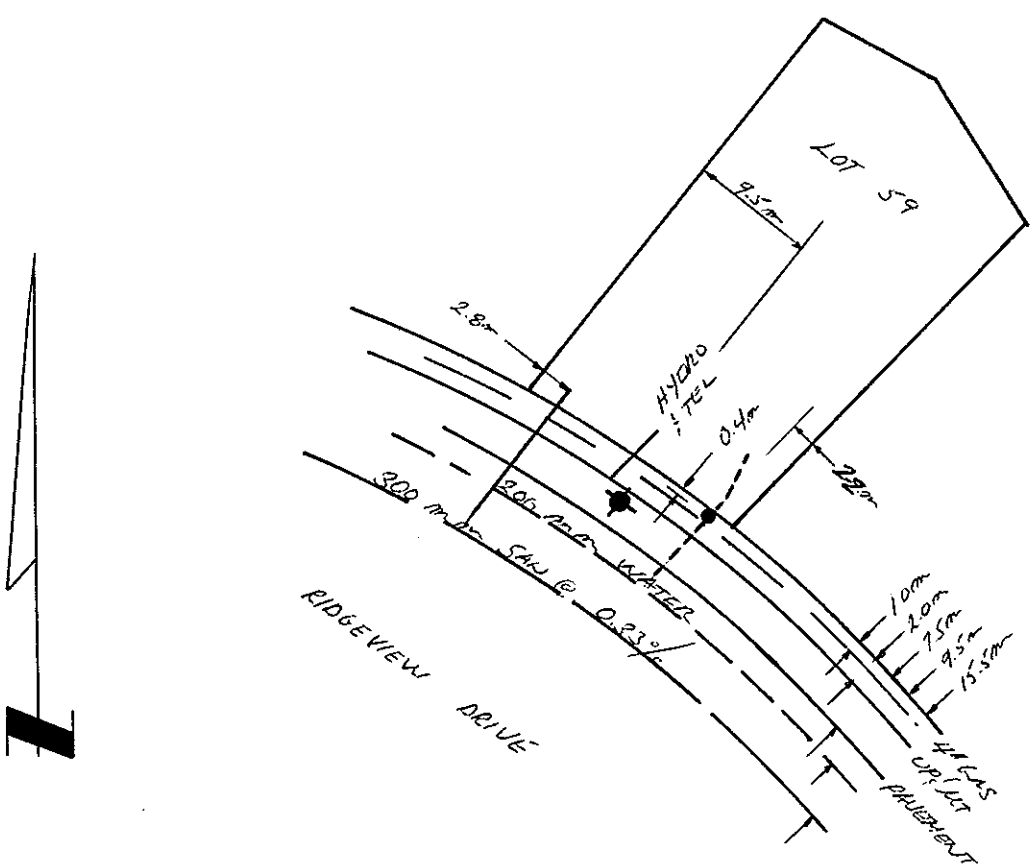
SITE PLAN N.T.S.