City of Prince George
HISTORY SHEET

007767706
007767731

SHEET NUMBER **1029** **Roll Number** 2861-000

Legal: LOT'S 13-14 BLOCK 129 D.L. 343 PLAN 1268

Address: 1605 THIRD AVE. PRINCE GEORGE, B.C. 1602 4th AVE.

Sanitary Connection: # 2275 SIZE - MATERIAL - INV. - CONNECTED -

Water Connection # - SIZE MATERIAL METER CONNECTED

Storm Connection: # - SIZE MATERIAL INV. CONNECTED

Cash Receipt No's: WATER SANITARY - STORM

CURB FROM PROPERTY LINE 10' PAVEMENT WIDTH 46'

B.C. HYDRO O.H. UNDERGROUND CONNECTION -

B.C. TELEPHONE O.H UNDERGROUND CONNECTION -

INLAND GAS IN LANE 3" ϕ MAIN.

Information Sheets: ENG. DWG. 1991
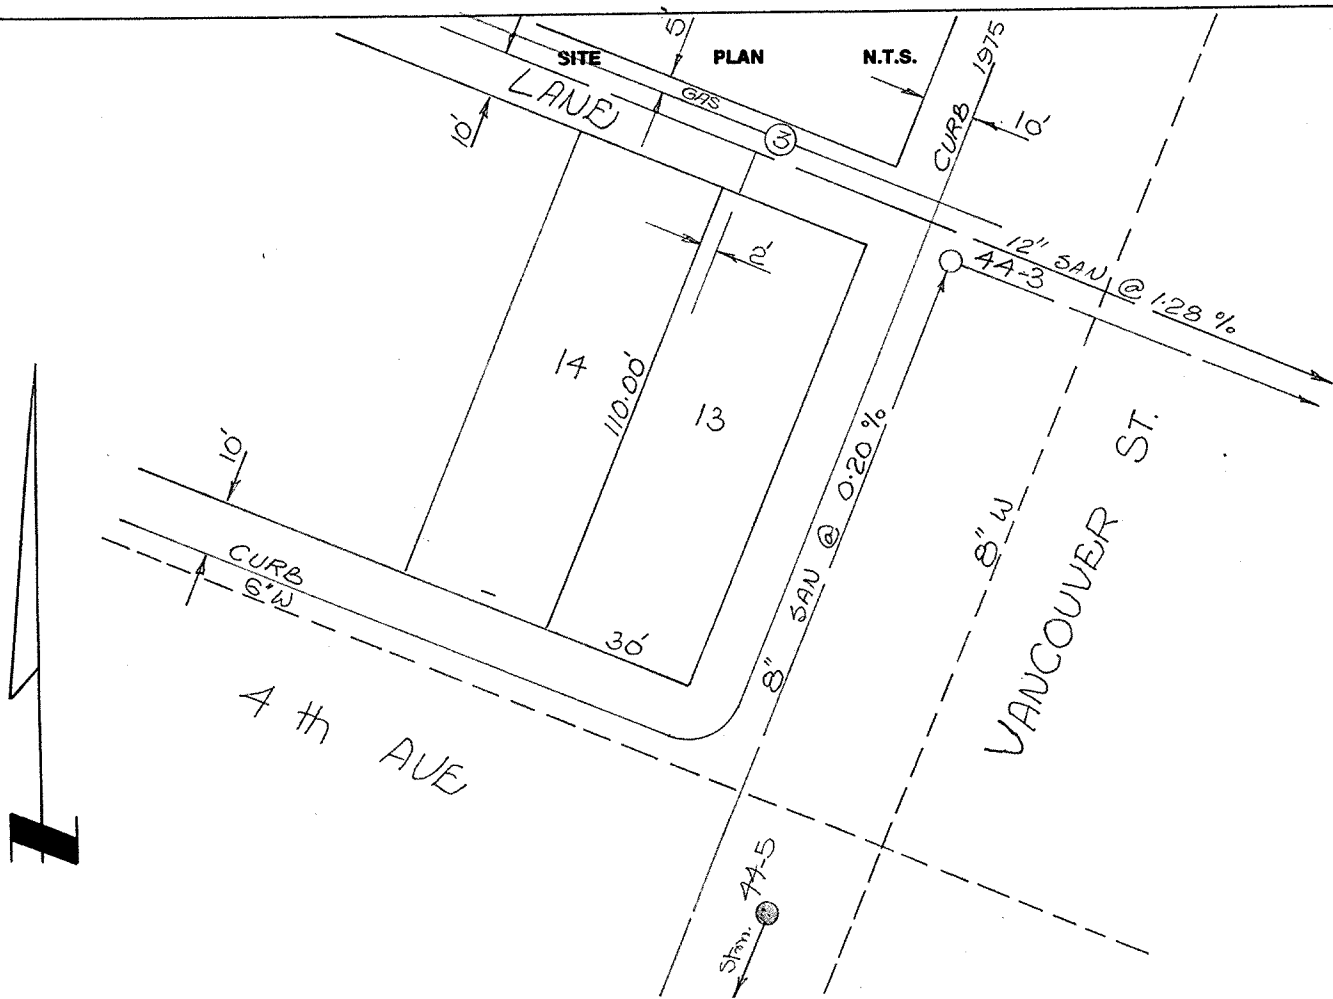
Comments: