City of Prince George
HISTORY SHEET

SHEET NUMBER № 1170 **Roll Number**

Legal: LOT'S 13-14 BLOCK 3 D.L. 937 PLAN 752

Address: 710 FREEMAN ST.

Sanitary Connection: # 1518 SIZE 100 mm MATERIAL A.C INV. CONNECTED

Water Connection # 918 SIZE 20 mm MATERIAL CU. METER CONNECTED

Storm Connection: # SIZE MATERIAL INV. CONNECTED

Cash Receipt No's: WATER SANITARY STORM

CURB FROM PROPERTY LINE 4.877m PAVEMENT WIDTH

B.C. HYDRO OVERHEAD UNDERGROUND CONNECTION

B.C. TELEPHONE OVERHEAD UNDERGROUND CONNECTION

INLAND GAS AS SHOWN IN LANE

Information Sheets:

Comments:

THE INFORMATION CONTAINED HEREIN IS FOR INTERNAL USE ONLY. NOT TO BE RELIED UPON UNLESS CONFIRMED BY SITE INSPECTION AND/OR INVESTIGATION.
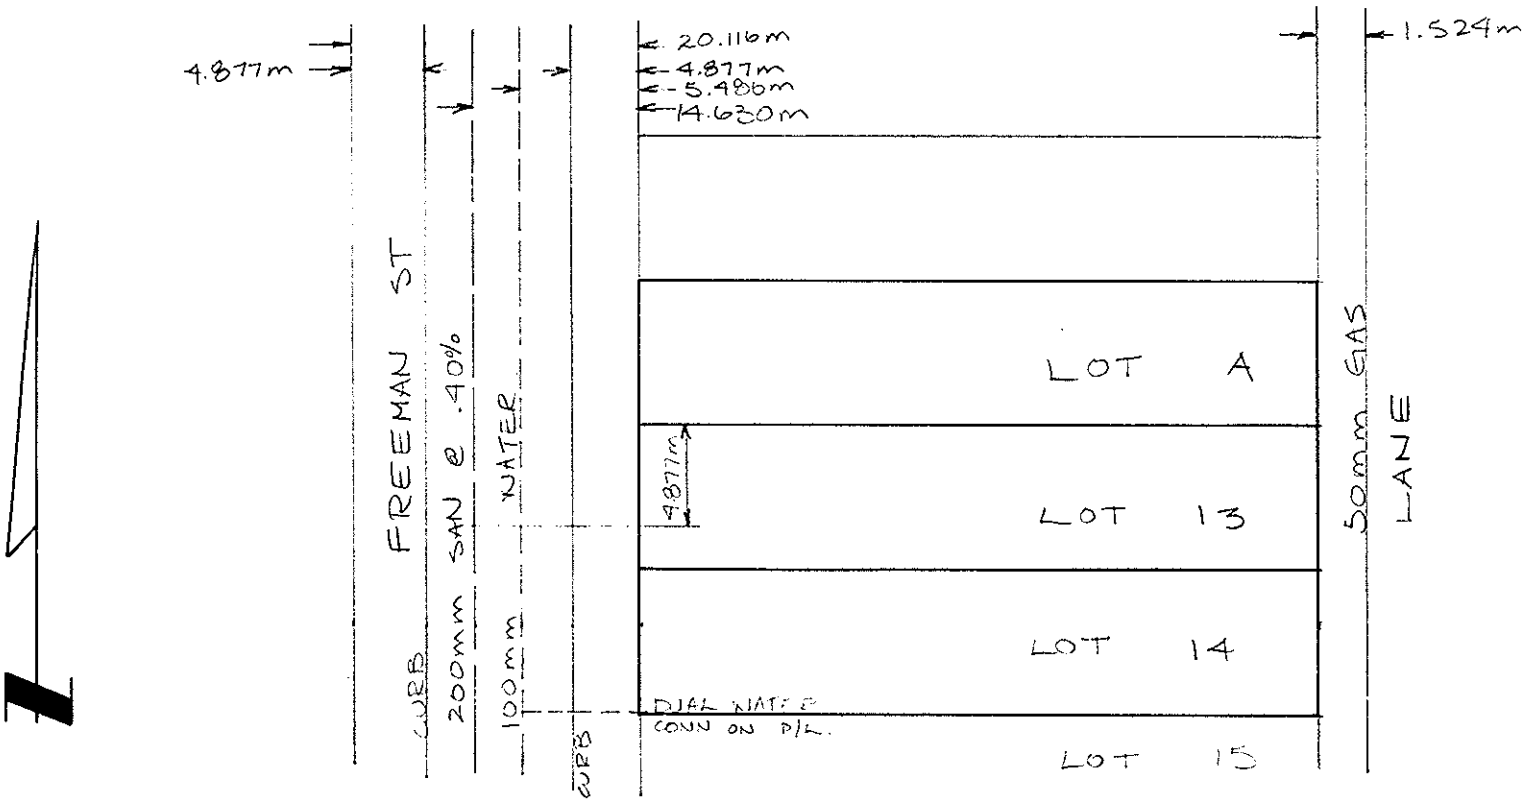
SITE PLAN N.T.S.