City of Prince George
HISTORY SHEET

007784228
007784244
007784261

S

SHEET NUMBER **1122** **Roll Number** 3034-000

Legal: LOT'S 16-18 BLOCK 137 D.L. 343 PLAN 1268

Address: 888 4th AVE.

Sanitary Connection: # 3351, 4226 SIZE –, 4" MATERIAL –, ACS. INV. 1857.00, 1860.18 CONNECTED YES, –

Water Connection # 242, 4011 SIZE 3/4", 3/4" MATERIAL Cu, Cu METER –, – CONNECTED –, –

Storm Connection: # – SIZE MATERIAL INV. CONNECTED –

Cash Receipt No's: WATER –, 2189 SANITARY 1271, 2188 STORM

CURB FROM PROPERTY LINE 8' PAVEMENT WIDTH 48'

B.C. HYDRO O.H UNDERGROUND CONNECTION –

B.C. TELEPHONE O.H UNDERGROUND CONNECTION –

INLAND GAS IN LANE 2" Φ MAIN.

Information Sheets: –

Comments: SAN #3351 + WATER

THE INFORMATION CONTAINED HEREIN IS FOR INTERNAL USE ONLY. NOT TO BE RELIED UPON UNLESS CONFIRMED BY SITE INSPECTION AND/OR INVESTIGATION.
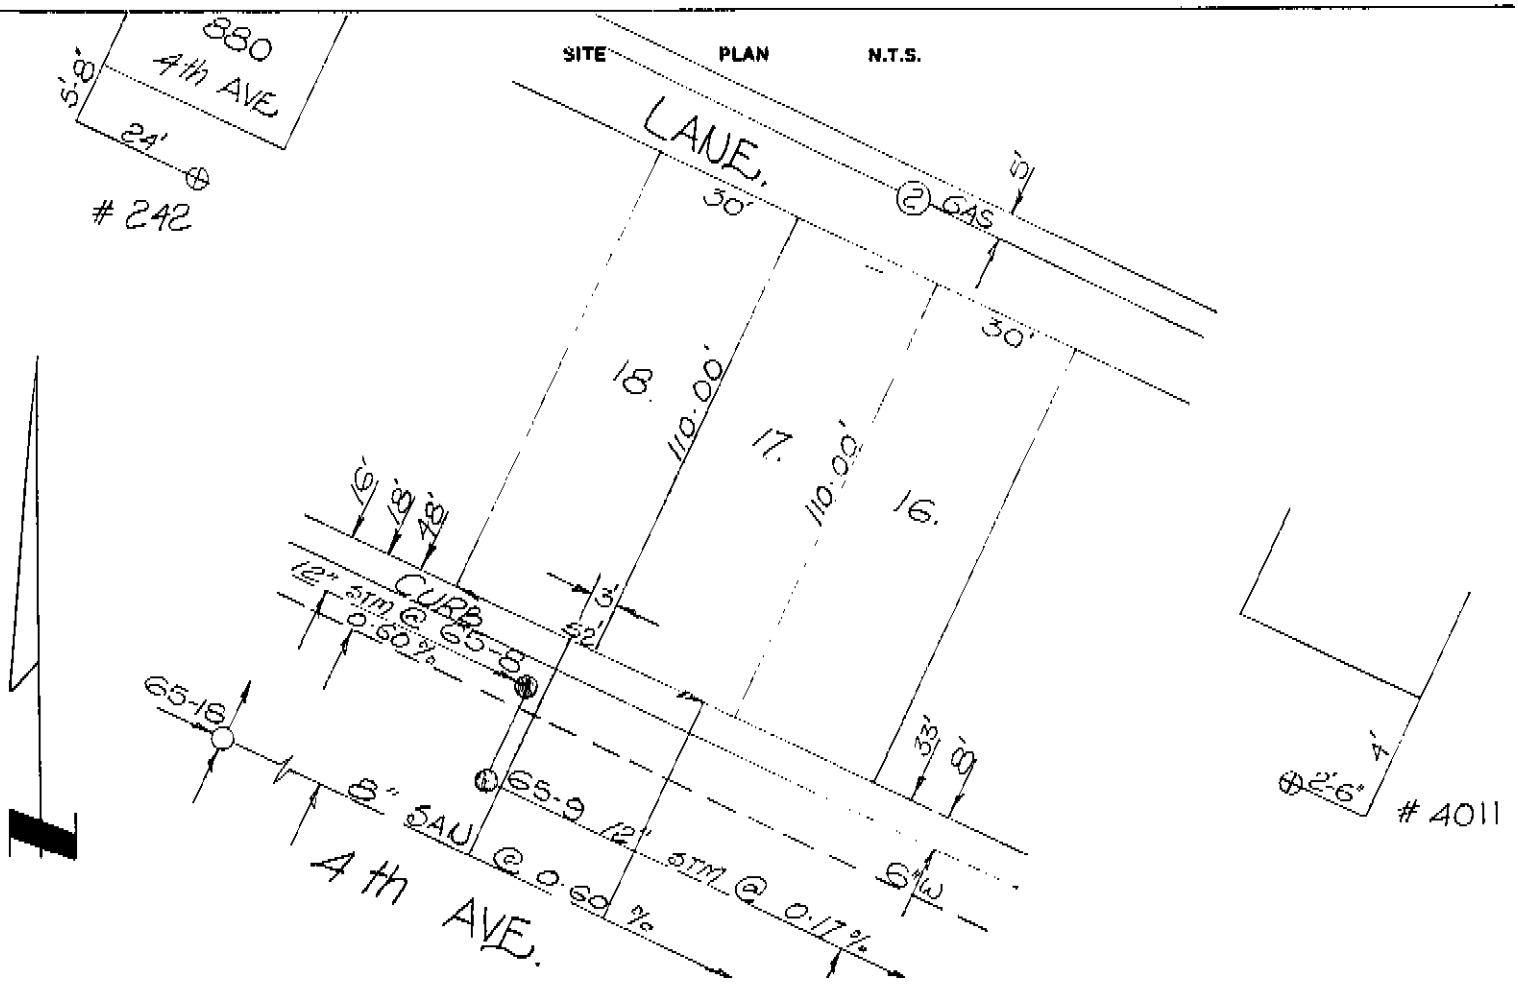
SITE PLAN N.T.S.