City of Prince George
HISTORY SHEET

00779748S
00779743
00779745I

SHEET NUMBER **1146** **Roll Number** 3094-000

Legal: LOT'S 15-17 BLOCK 140 D.L. 343 PLAN 1268

Address: 548-68 4th AVE.

Sanitary Connection: # 4345 SIZE 4" MATERIAL A.C. INV. 1861.55 CONNECTED -

Water Connection # 4122 SIZE 1" MATERIAL Cu METER - CONNECTED -

Storm Connection: # - SIZE MATERIAL INV. CONNECTED -

Cash Receipt No's: WATER 2317 SANITARY 2316 STORM

CURB FROM PROPERTY LINE 8' PAVEMENT WIDTH 48'

B.C. HYDRO O.H. UNDERGROUND CONNECTION -

B.C. TELEPHONE O.H UNDERGROUND CONNECTION -

INLAND GAS IN LANE 2" ϕ MAIN.

Information Sheets: -
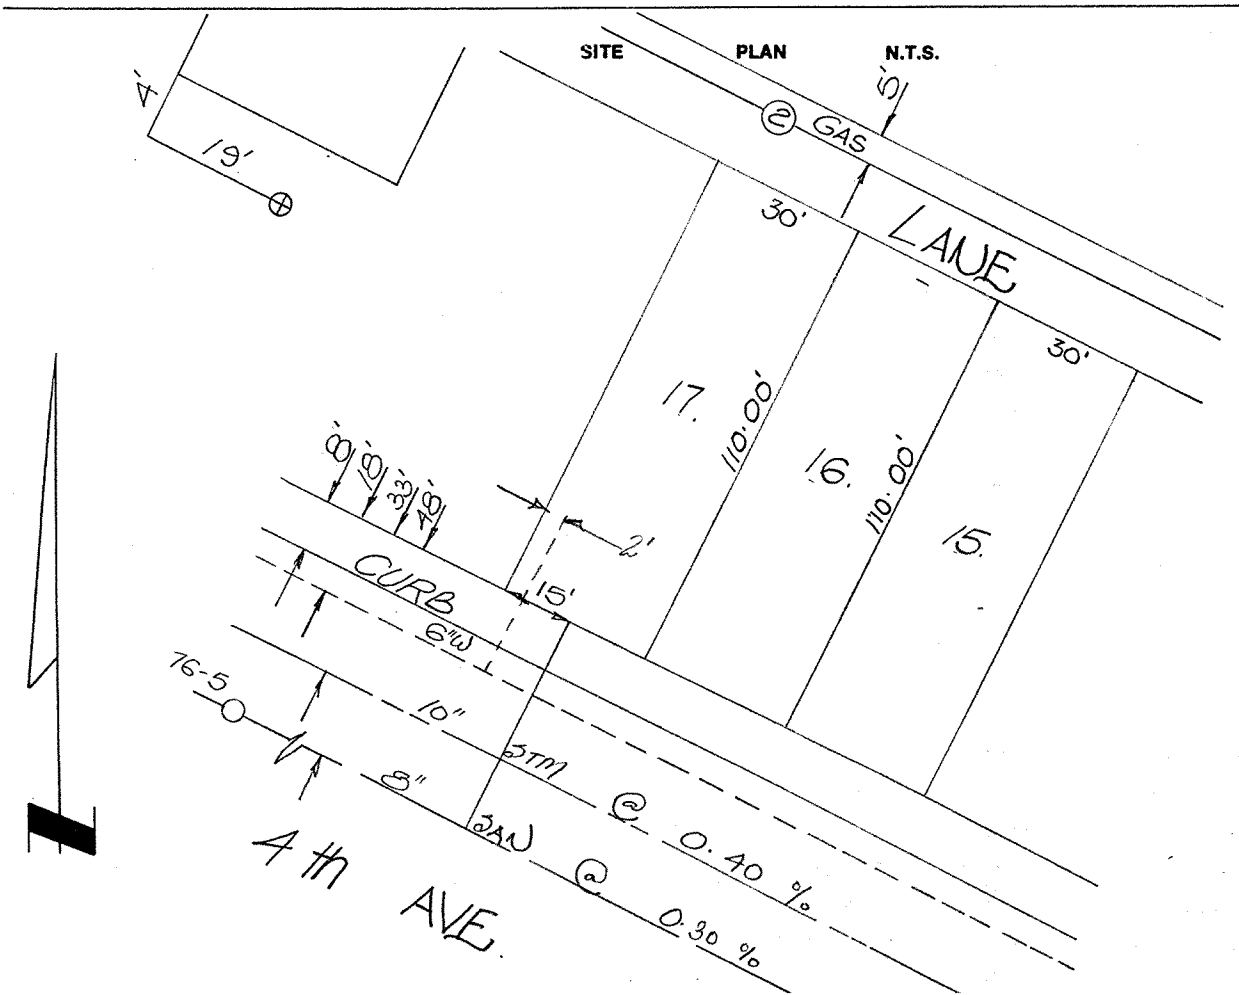
Comments: