007797966
007797974

City of Prince George
HISTORY SHEET

SHEET NUMBER 1056 **Roll Number** 2940-000

Legal: LOT'S 1-2 BLOCK 133 D.L. 343 PLAN 1268

Address: ROYAL BANK OF CANADA. PRINCE GEORGE, B.C. 1299 THIRD AVE. (1299 THIRD AVE.)

Sanitary Connection: # 2335, 2336, 3964 SIZE -, -, 6" MATERIAL -, -, ACS. INV. -, -, 1867.30 CONNECTED Yes, YES, YE

Water Connection # 3499 SIZE 1¼" MATERIAL Cu METER - CONNECTED -

Storm Connection: # 124 SIZE - MATERIAL - INV. 1872.38 CONNECTED -

Cash Receipt No's: WATER - SANITARY -, -, 1989 STORM 1857

CURB FROM PROPERTY LINE 10' PAVEMENT WIDTH 60'

B.C. HYDRO O.H. UNDERGROUND CONNECTION -

B.C. TELEPHONE O.H UNDERGROUND CONNECTION -

INLAND GAS IN LANE 3" ϕ MAIN.

Information Sheets:

Comments:

The information contained herein is for internal use only. Not to be relied upon unless confirmed by site inspection and/or investigation.
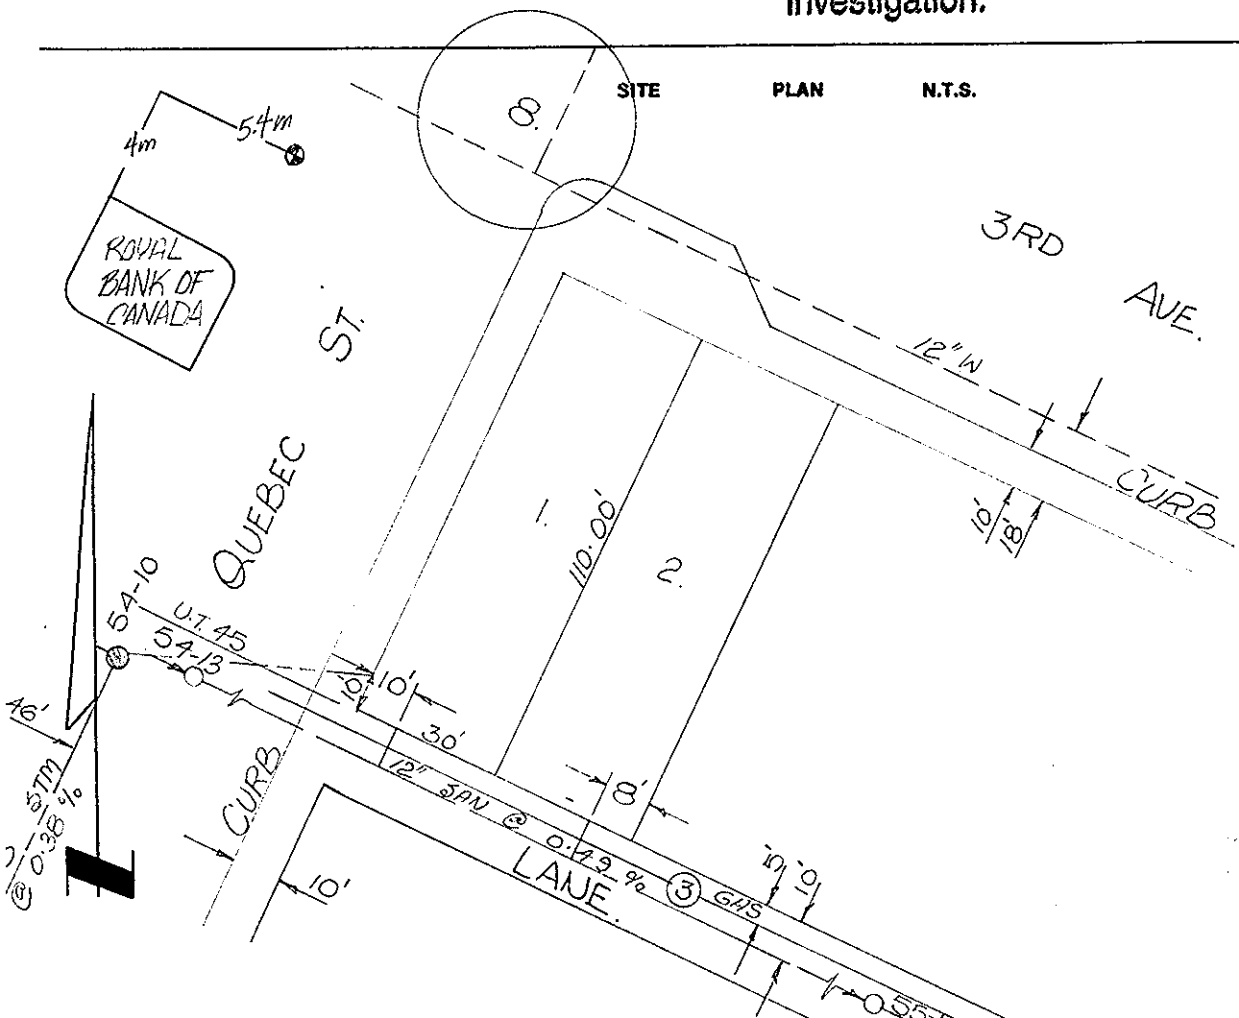
SITE PLAN N.T.S.