City of Prince George
HISTORY SHEET

0078 10512 0078 10547
0078 10521 0078 10563
0078 10539

SHEET NUMBER **1170** **Roll Number** 3209-000

Legal: LOT'S 16-20 BLOCK 146 D.L. 343 PLAN 1268

Address: 798 5th AVE.

Sanitary Connection: # - SIZE MATERIAL INV. CONNECTED

Water Connection # - SIZE MATERIAL METER CONNECTED

Storm Connection: # - SIZE MATERIAL INV. CONNECTED

Cash Receipt No's: WATER SANITARY STORM

CURB FROM PROPERTY LINE 19' PAVEMENT WIDTH -

B.C. HYDRO O.H. UNDERGROUND CONNECTION

B.C. TELEPHONE O.H UNDERGROUND CONNECTION

INLAND GAS -

Information Sheets: -
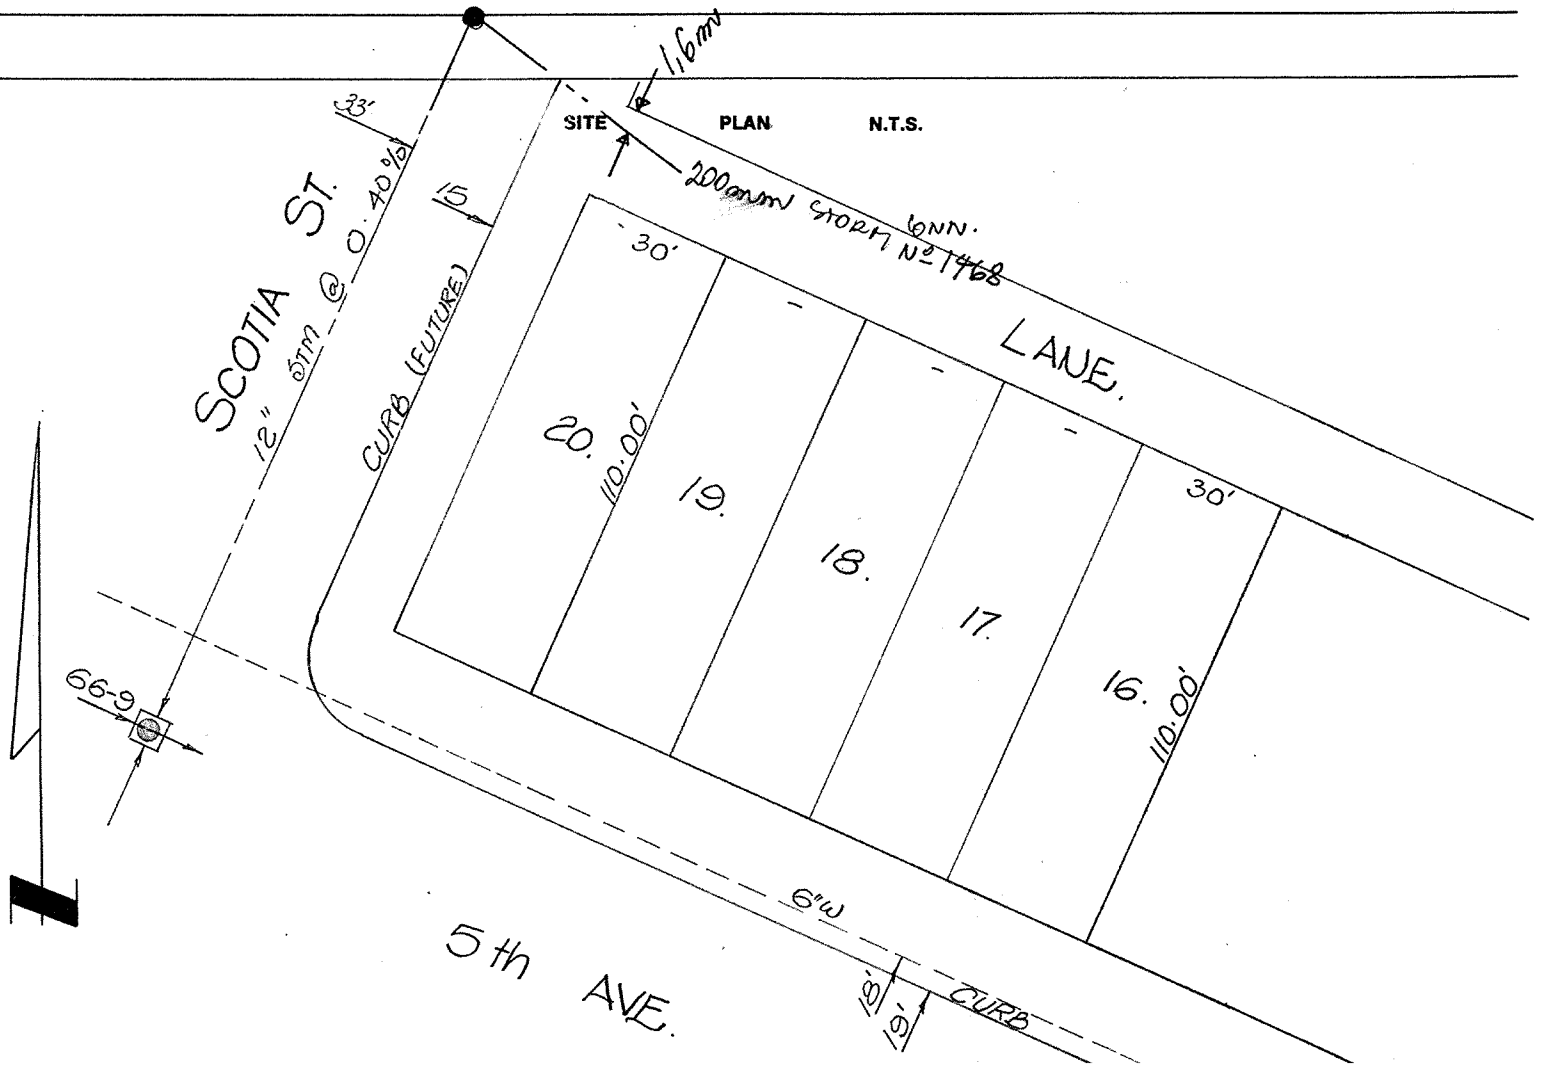
Comments: STORM CONN.