438

City of Prince George
HISTORY SHEET

SHEET NUMBER № 4864 **Roll Number**

Legal: LOT'S A - A BLOCK 2 - 29 D.L. 937 PLAN 762

Address: 702 EWERT STREET

Sanitary Connection: # 9862 SIZE 4" MATERIAL A.C. INV. CONNECTED

Water Connection # 9862 SIZE 3/4" MATERIAL Copper METER CONNECTED

Storm Connection: # SIZE MATERIAL INV. CONNECTED

Cash Receipt No's: WATER SANITARY STORM

CURB FROM PROPERTY LINE 16' PAVEMENT WIDTH 34'

B.C. HYDRO UNDERGROUND CONNECTION

B.C. TELEPHONE UNDERGROUND CONNECTION

INLAND GAS

Information Sheets:

Comments:
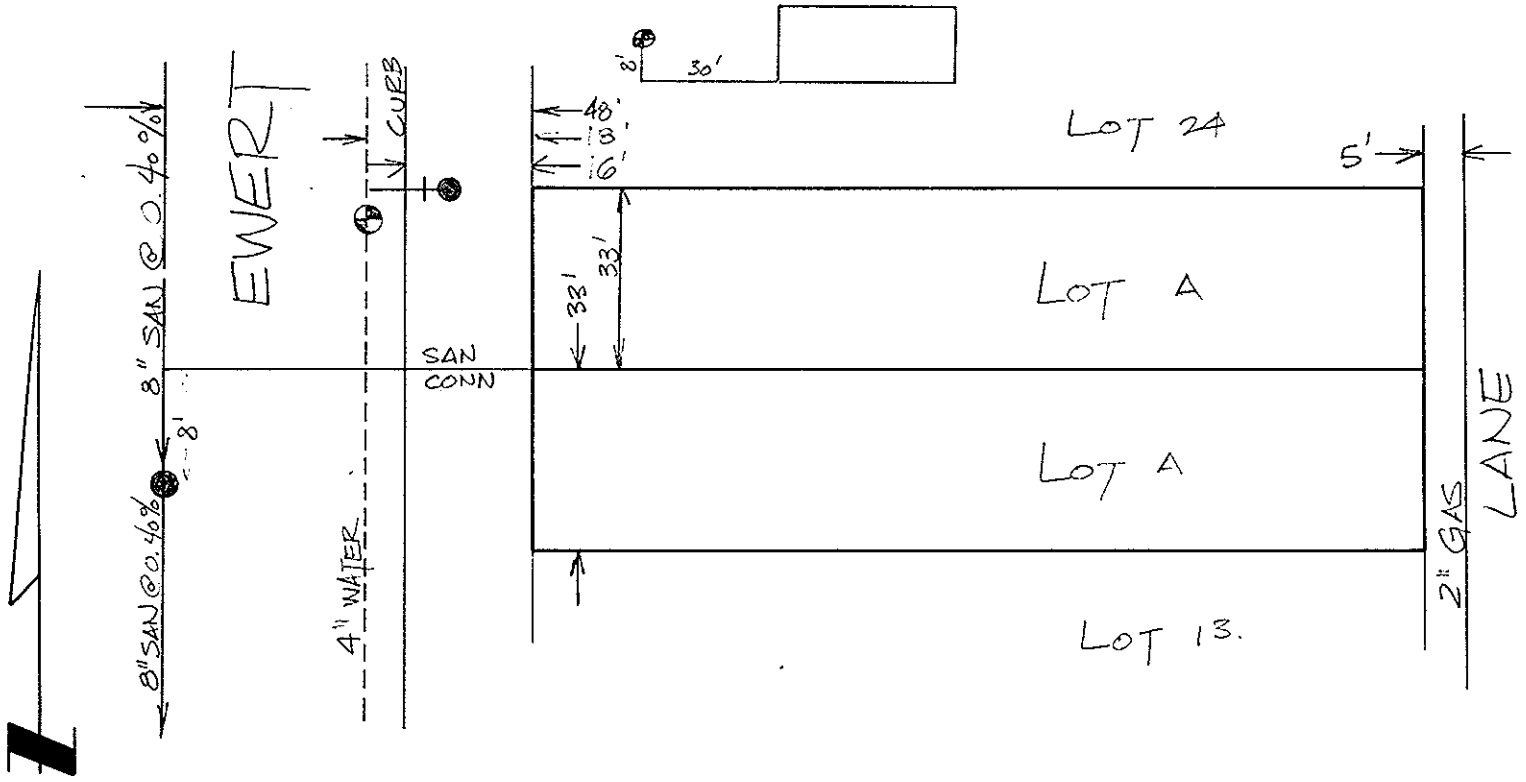
SITE PLAN N.T.S.