City of Prince George
HISTORY SHEET

007835779

SHEET NUMBER **Roll Number**

Legal: LOT'S 40 BLOCK D.L. 913 PLAN 20385

Address: 2759 LONSDALE ST.

Sanitary Connection: # 8937 SIZE 100 mm MATERIAL AC INV. CONNECTED

Water Connection # 8937 SIZE 20 mm MATERIAL Cu METER CONNECTED

Storm Connection: # SIZE MATERIAL INV. CONNECTED

Cash Receipt No's: WATER 392 SANITARY 391 STORM

CURB FROM PROPERTY LINE PAVEMENT WIDTH

B.C. HYDRO UNDERGROUND CONNECTION

B.C. TELEPHONE UNDERGROUND CONNECTION

INLAND GAS

Information Sheets:

Comments:
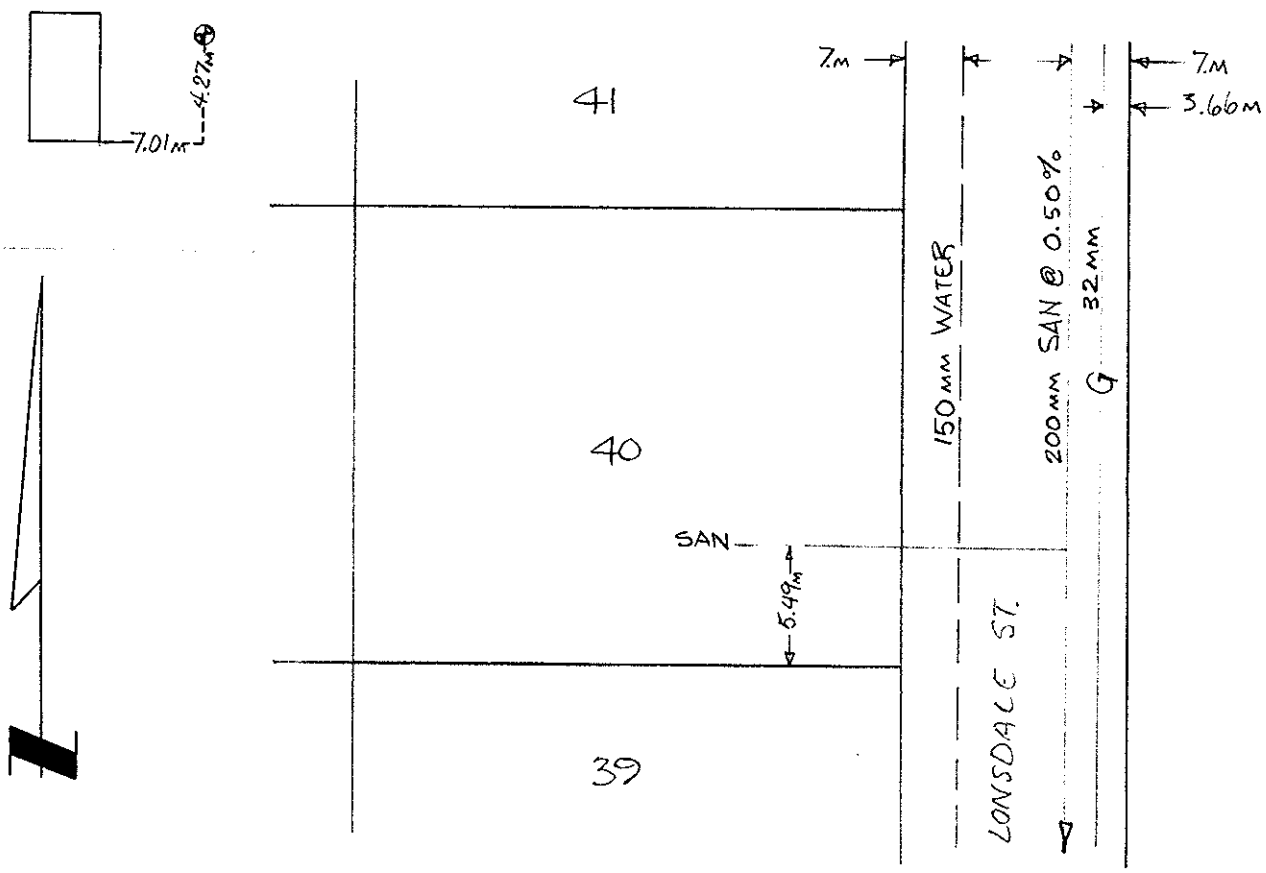
SITE PLAN N.T.S.