City of Prince George
HISTORY SHEET

SHEET NUMBER № 2343 **Roll Number**

Legal: LOT'S 14-15 BLOCK 24 D.L. 931 PLAN 752

Address: 622 JOHNSON STREET

Sanitary Connection: # 2826 SIZE 100mm MATERIAL INV. CONNECTED

Water Connection # 1760 SIZE 19mm MATERIAL CU METER CONNECTED

Storm Connection: # SIZE MATERIAL INV. CONNECTED

Cash Receipt No's: WATER SANITARY 18 STORM

CURB FROM PROPERTY LINE 4.877m PAVEMENT WIDTH

B.C. HYDRO OVERHEAD UNDERGROUND CONNECTION

B.C. TELEPHONE OVERHEAD UNDERGROUND CONNECTION

INLAND GAS

Information Sheets:

Comments:
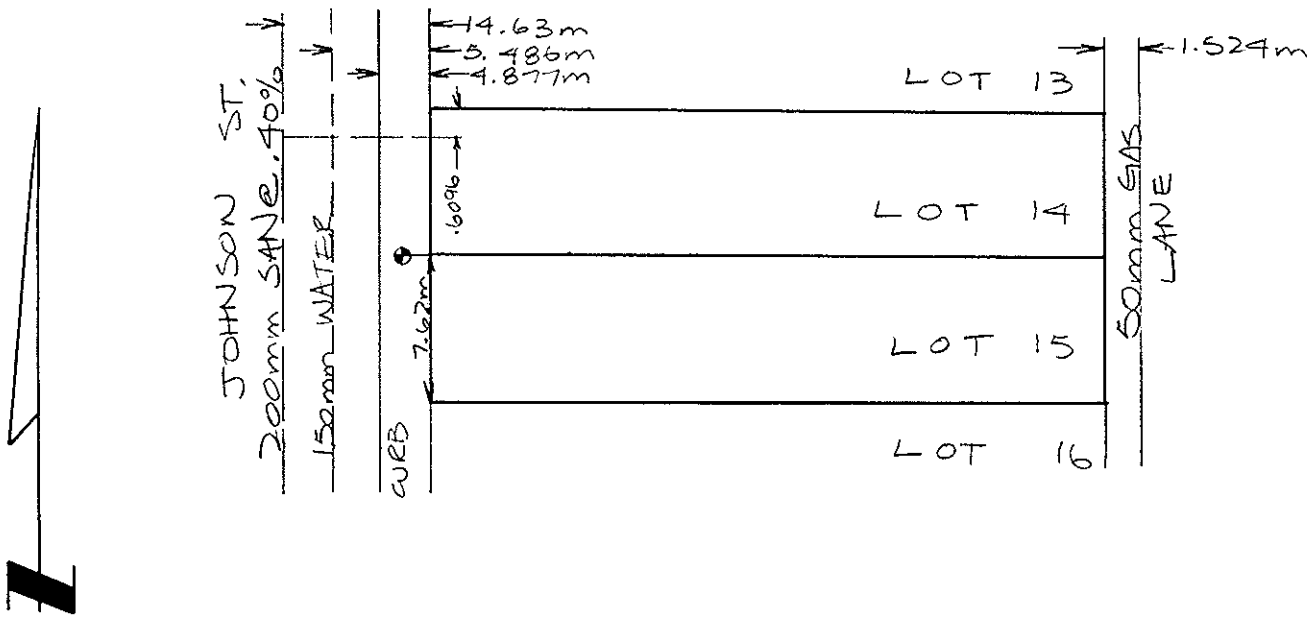
SITE PLAN N.T.S.