City of Prince George
HISTORY SHEET

007897105

SHEET NUMBER № 2262 **Roll Number** 007897413

Legal: LOT'S 9-10 BLOCK 35 D.L. 937 PLAN 752

Address: 521 GILLETTE STREET

Sanitary Connection: # 6583 SIZE 100mm MATERIAL AC. INV. CONNECTED

Water Connection # SIZE MATERIAL METER CONNECTED

Storm Connection: # SIZE MATERIAL INV. CONNECTED

Cash Receipt No's: WATER SANITARY 45 STORM

CURB FROM PROPERTY LINE 4.877m PAVEMENT WIDTH

B.C. HYDRO OVERHEAD UNDERGROUND CONNECTION

B.C. TELEPHONE OVERHEAD UNDERGROUND CONNECTION

INLAND GAS

Information Sheets:

Comments:
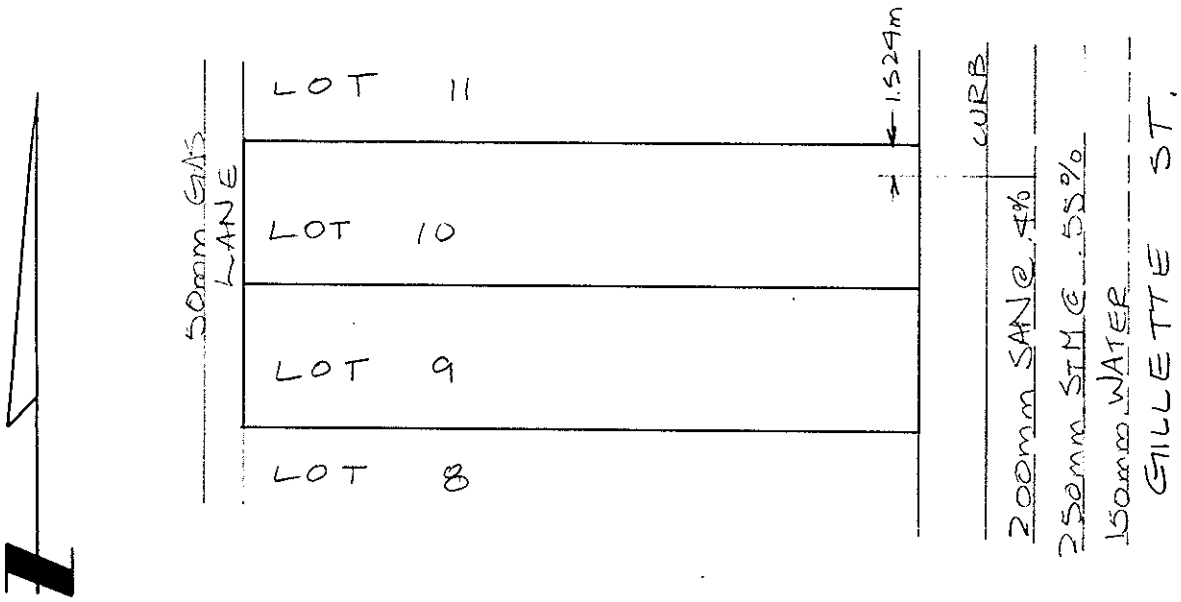
SITE PLAN N.T.S.