City of Prince George
HISTORY SHEET

SHEET NUMBER № 1250 **Roll Number**

Legal: LOT'S 11-12 BLOCK 26 D.L. 937 PLAN 752

Address: 615 GILLETTE STREET

Sanitary Connection: # 1893 SIZE MATERIAL INV. CONNECTED

Water Connection # 993 SIZE 19mm MATERIAL CU METER CONNECTED

Storm Connection: # SIZE MATERIAL INV. CONNECTED

Cash Receipt No's: WATER SANITARY 265 STORM

CURB FROM PROPERTY LINE 4.877m PAVEMENT WIDTH

B.C. HYDRO OVERHEAD UNDERGROUND CONNECTION

B.C. TELEPHONE OVERHEAD UNDERGROUND CONNECTION

INLAND GAS

Information Sheets:

Comments:
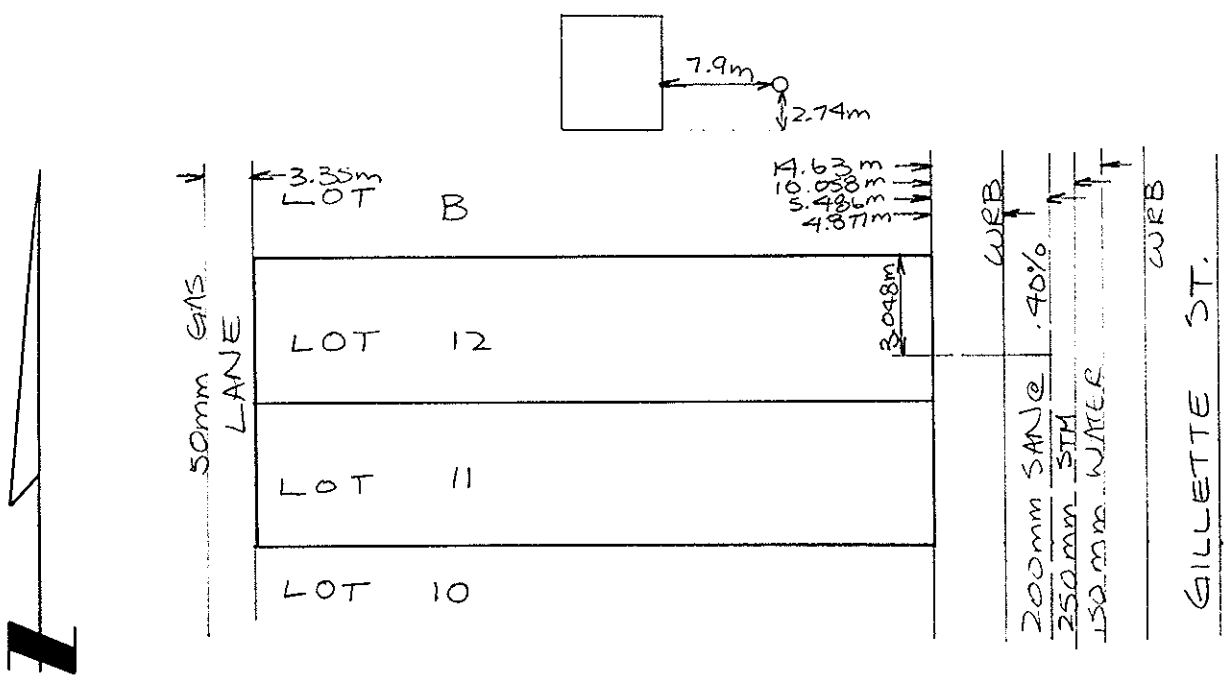
SITE PLAN N.T.S.