City of Prince George
HISTORY SHEET

SHEET NUMBER 007910762

Roll Number 007910797

Legal: LOT'S 23-24 BLOCK 49 D.L. 937 PLAN 752

Address: 484 N. NICHOLSON ST.

Sanitary Connection: # 3230 SIZE 100mm MATERIAL A.C. INV. 602.347 CONNECTED

Water Connection # 3283 SIZE 20mm MATERIAL CU. METER CONNECTED

Storm Connection: # SIZE MATERIAL INV. CONNECTED

Cash Receipt No's: WATER SANITARY STORM

CURB FROM PROPERTY LINE 4.877m PAVEMENT WIDTH 10.363m

B.C. HYDRO O/H UNDERGROUND CONNECTION

B.C. TELEPHONE O/H UNDERGROUND CONNECTION

INLAND GAS 1.524 m FROM PL IN LANE.

Information Sheets:

Comments: WITH THAW WIRE.

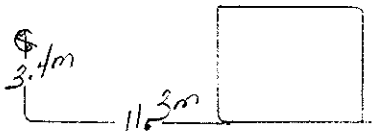
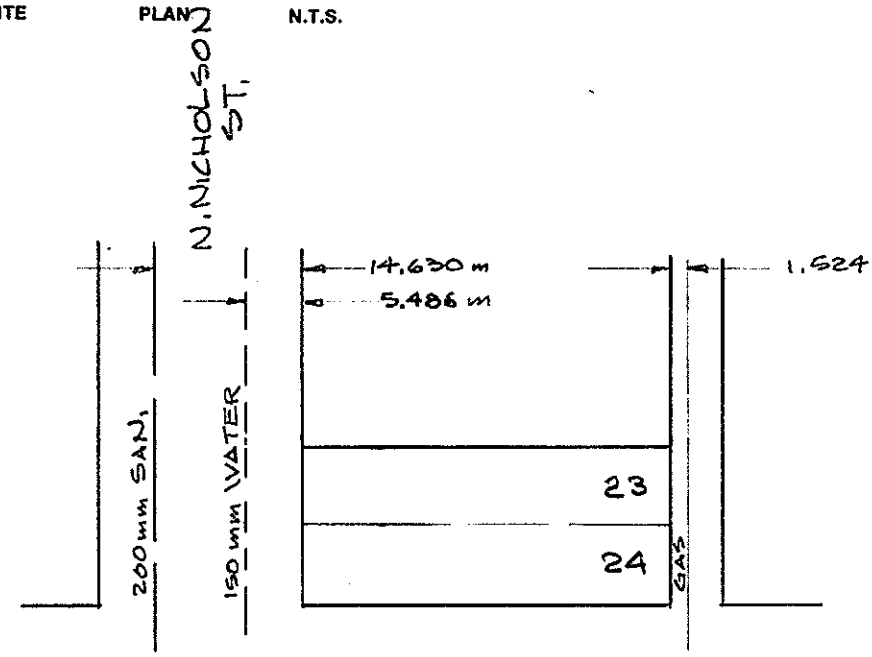
SITE PLAN N.T.S.