# City of Prince George
## HISTORY SHEET

SHEET NUMBER 3396 **Roll Number** 0079/4601

**Legal:** LOT'S 10 BLOCK D.L. 2611 PLAN 25193

**Address:** 4210 JACKSON CRES.

**Sanitary Connection:** # 12310 SIZE 100 MM MATERIAL A.C. INV. 1974.65 CONNECTED

**Water Connection** # 12310 SIZE 19mm MATERIAL P.V.C. METER CONNECTED

**Storm Connection:** # SIZE MATERIAL INV. CONNECTED

**Cash Receipt No's:** WATER SANITARY STORM

CURB FROM PROPERTY LINE 4.9 M PAVEMENT WIDTH 10.4M

B.C. HYDRO UP-250 UNDERGROUND CONNECTION

B.C. TELEPHONE UT-375 UNDERGROUND CONNECTION

INLAND GAS AS SHOWN

**Information Sheets:**

**Comments:** SEE ENG. DWG. 2841 & L.B. # 375 & 366
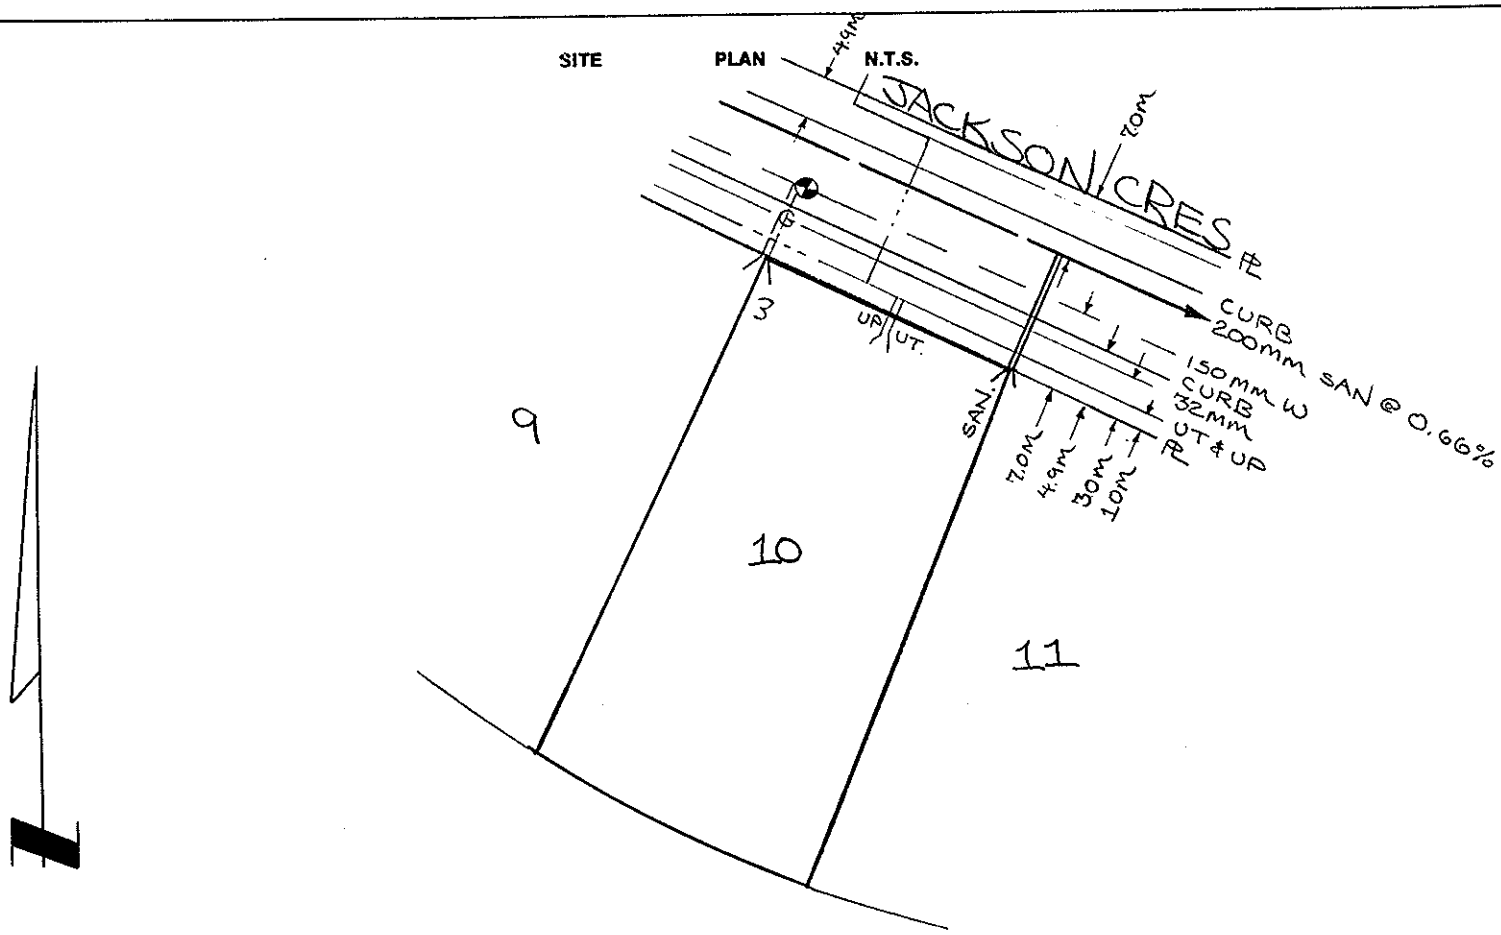
SITE PLAN N.T.S.