City of Prince George
HISTORY SHEET

007116337
009916320

SHEET NUMBER № 2258 **Roll Number** 009916 451

Legal: LOT'S 1-3 BLOCK 35 D.L. 937 PLAN 752

Address: 585 GILLETTE STREET

Sanitary Connection: #	1987	SIZE	MATERIAL	INV.	CONNECTED
Water Connection #	1061	SIZE 19mm	MATERIAL (W)	METER	CONNECTED
Storm Connection: #		SIZE	MATERIAL	INV.	CONNECTED

Cash Receipt No's: WATER SANITARY 412 STORM

CURB FROM PROPERTY LINE 4.877m PAVEMENT WIDTH

B.C. HYDRO OVERHEAD UNDERGROUND CONNECTION

B.C. TELEPHONE OVERHEAD UNDERGROUND CONNECTION

INLAND GAS

Information Sheets:

Comments:
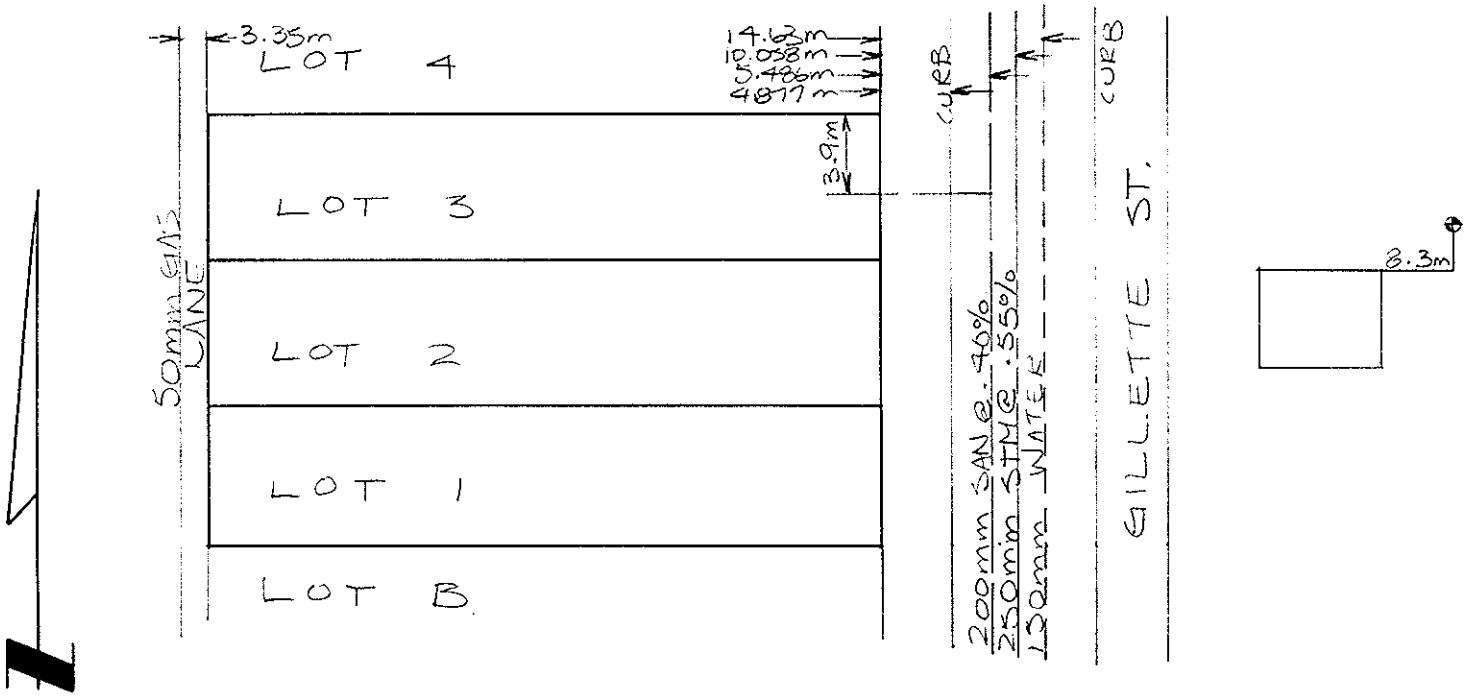
SITE PLAN N.T.S.