City of Prince George
HISTORY SHEET

SHEET NUMBER 2159 Roll Number 07922035

Legal: LOT'S 9 BLOCK D.L. 633 PLAN 25777

Address: 5724 KOVACHICH DRIVE

Sanitary Connection: # SIZE 100mm ϕ MATERIAL PVC INV. 673.64 m CONNECTED

Water Connection # SIZE 20mm ϕ MATERIAL Cu METER CONNECTED

Storm Connection: # SIZE 100 mm ϕ MATERIAL PVC INV. 673.52 m CONNECTED

Cash Receipt No's: WATER SANITARY STORM

CURB FROM PROPERTY LINE 5 m PAVEMENT WIDTH 10 m

B.C. HYDRO U/G CONNECTION @ MID LOT UNDERGROUND CONNECTION

B.C. TELEPHONE U/G CONNECTION @ MID LOT UNDERGROUND CONNECTION

INLAND GAS

THE INFORMATION CONTAINED HEREIN IS FOR INTERNAL USE ONLY. NOT TO BE RELIED UPON UNLESS CONFIRMED BY SITE INSPECTION AND/OR INVESTIGATION.

Information Sheets:

Comments: GEODETIC BENCH MARK EL. 682.067 m

BLACKBURN ELEMENTARY SCHOOL GYM

TABLET ON CONCRETE WALL NORTH SIDE

SITE PLAN N.T.S.

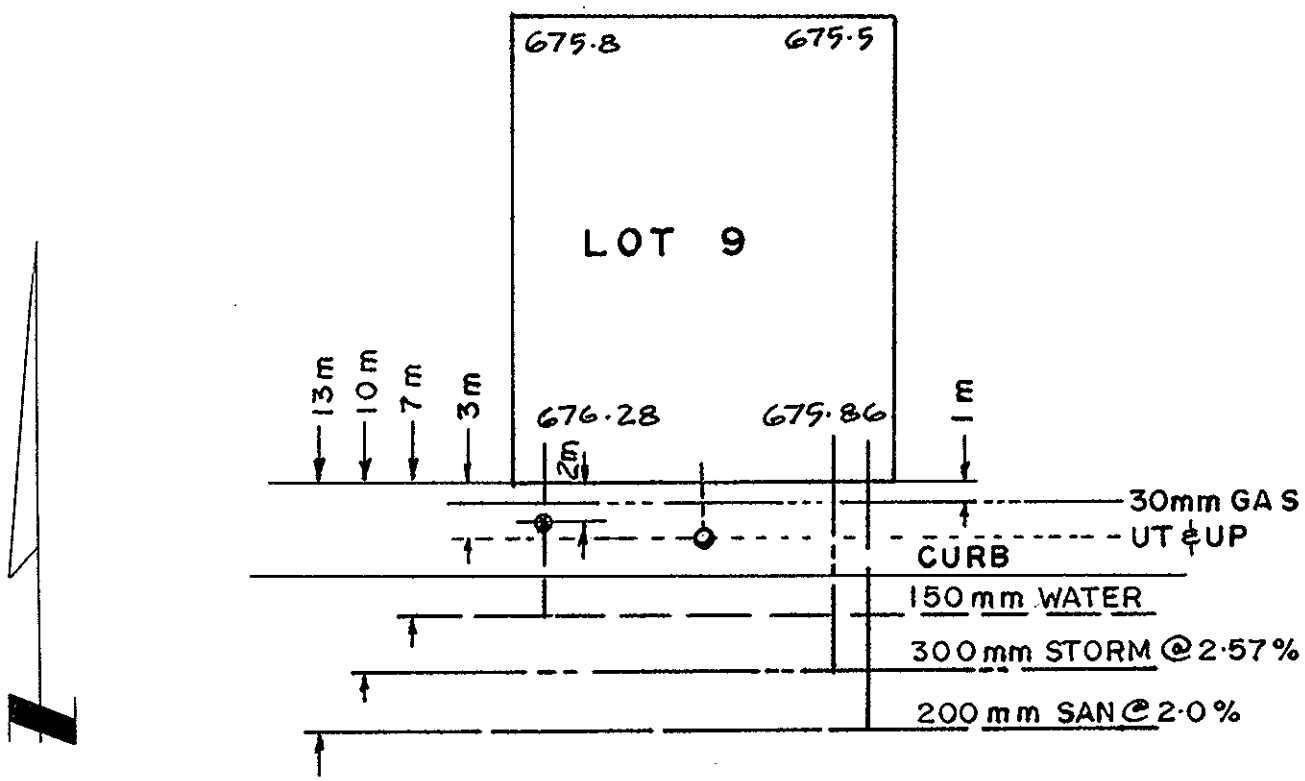

KOVACHICH STREET