City of Prince George
HISTORY SHEET

007938

SHEET NUMBER № 2058 **Roll Number** 225

Legal: LOT'S 13 - A BLOCK 38 D.L. 937 PLAN 752

Address: 406 FREEMAN STREET

Sanitary Connection: # 5984 SIZE 100mm MATERIAL AC INV. CONNECTED

Water Connection # 1142 SIZE 19mm MATERIAL CU METER CONNECTED

Storm Connection: # SIZE MATERIAL INV. CONNECTED

Cash Receipt No's: WATER SANITARY STORM

CURB FROM PROPERTY LINE PAVEMENT WIDTH

B.C. HYDRO UNDERGROUND CONNECTION

B.C. TELEPHONE UNDERGROUND CONNECTION

INLAND GAS

Information Sheets:

Comments:
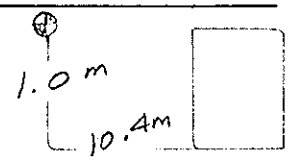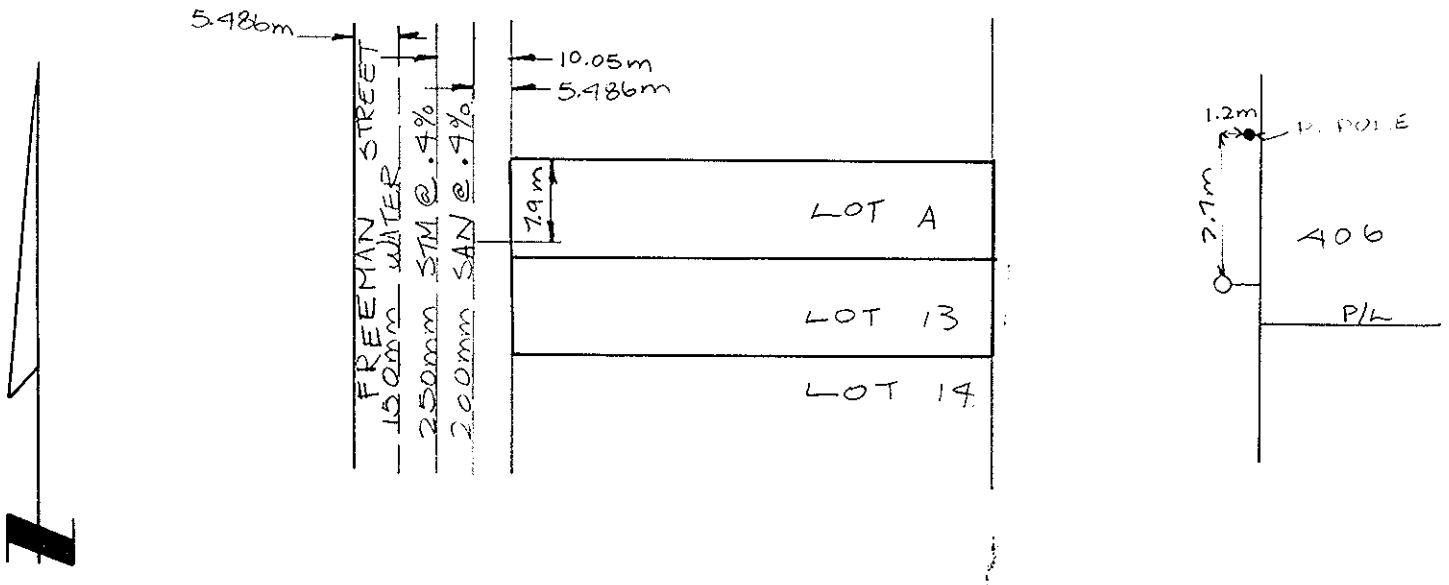
SITE PLAN N.T.S.