City of Prince George
HISTORY SHEET

007 942 737 007 942 788
007 942 753 007 942 796

Installation Date: **PID:** 007 942 761 012 816 833

Legal: Lot 1-6 **Blk:** 153 **DL:** 343 **PL:** 1268

Address: 1465 4th Ave & 400-444 Victoria St

Fibreoptics						**Depth:**	**Connected:**
Sanitary Connection #:	4360	**Size:**	150mm	**Material:**	AC	**Depth:**	**Connected:** Y
Sanitary Connection #:	2911	**Size:**	100mm	**Material:**	UNK	**Depth:**	**Connected:** Y
Sanitary Connection #:		**Size:**		**Material:**		**Depth:**	**Connected:**
Sanitary Connection #:		**Size:**		**Material:**		**Depth:**	**Connected:**
Water Connection #:	4135	**Size:**	50mm	**Material:**	CU	**Depth:**	**Connected:** Y
Water Connection #:	2856	**Size:**	unknown	**Material:**	UNK	**Depth:**	**Connected:**
Water Connection #:		**Size:**		**Material:**		**Depth:**	**Connected:**
Water Connection #:		**Size:**		**Material:**		**Depth:**	**Connected:**
Storm Connection #:	1201	**Size:**	150mm	**Material:**	AC	**Depth:**	**Connected**
Storm Connection #:		**Size:**		**Material:**		**Depth:**	**Connected**
Storm Connection #:		**Size:**		**Material:**		**Depth:**	**Connected**
Storm Connection #:		**Size:**		**Material:**		**Depth:**	**Connected**

Cash Receipt Nos:	**Water** 2362	**Sanitary** 2361		**Storm** 2040	
Cash Receipt Nos:	**Water**	**Sanitary** 377		**Storm**	
Cash Receipt Nos:	**Water**	**Sanitary**		**Storm**	
Cash Receipt Nos:	**Water**	**Sanitary**		**Storm**	

Curb from Property Line 3.048m **Pavement Width** 18.288m

Shaw
BC Hydro in lane UP 109 **U/G Connection**
Telus in lane UT 153 **U/G Connection**
Terasen in lane 3" main
Information Sheets: 345, 305
Comments:

The information contained herein is for internal use only. Not to be relied upon unless confirmed by site inspection and/or investigation.See page 2 for drawing locations

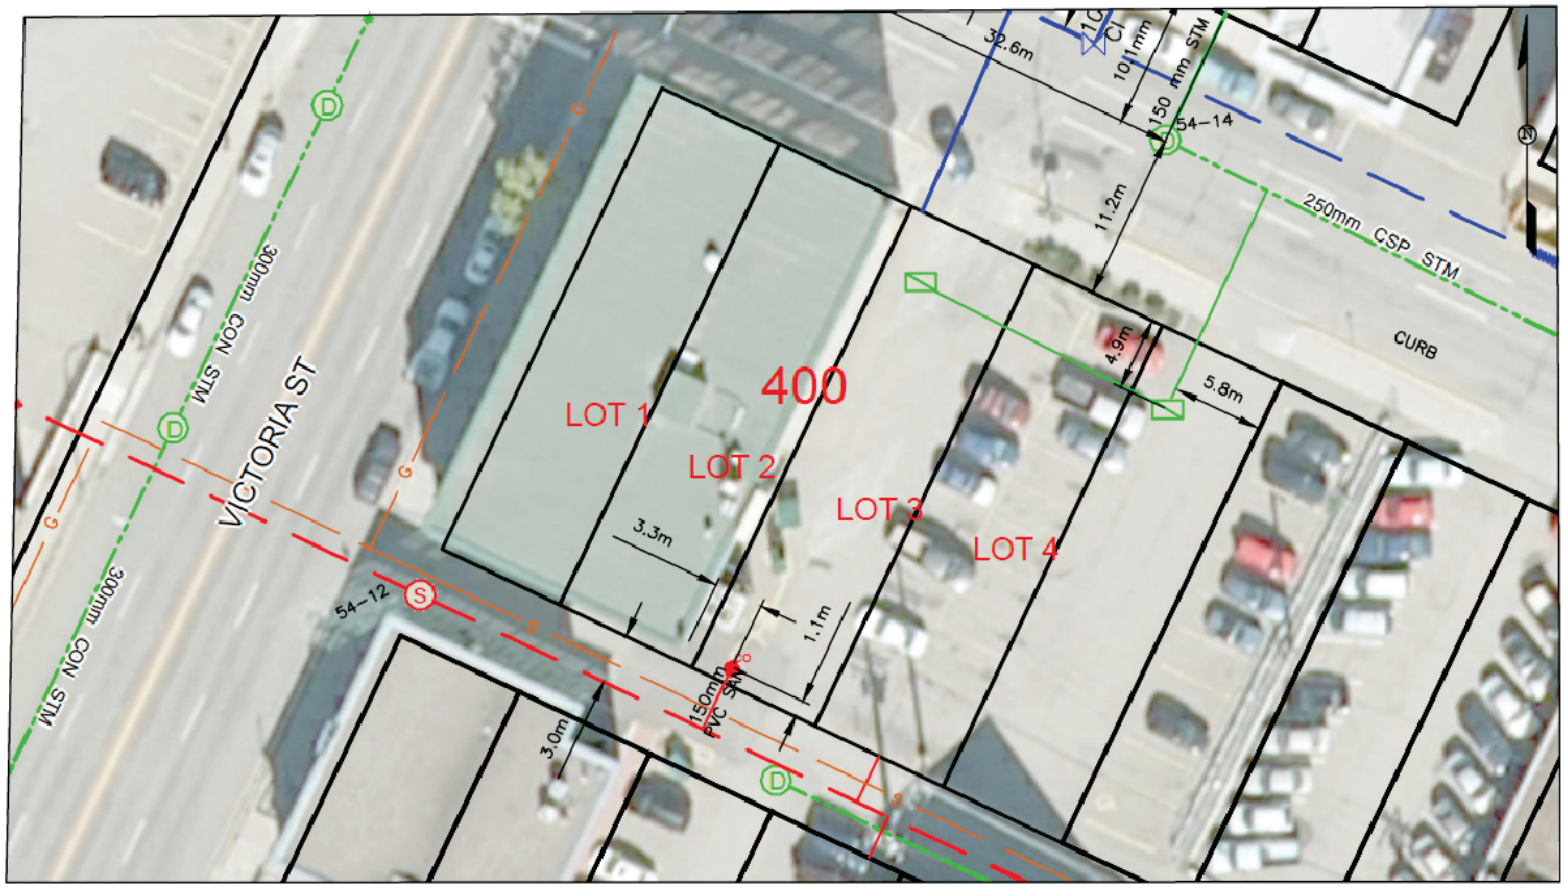
VICTORIA ST
300mm CON STM
300mm CON STM
400
LOT 1
LOT 2
LOT 3
LOT 4
54-12
54-14
3.3m
1.1m
3.0m
150mm PVC SAN
30.6m
10.1mm
150 mm STM
11.2m
250mm CSP STM
CURB
4.9m
5.8m