City of Prince George
HISTORY SHEET

PID: 007 942 737 007 942 788
007 942 753 007 942 796
007 942 761 012 816 833

Installation Date:

Legal: Lot 1-6 **Blk:** 153 **DL:** 343 **PL:** 1268

Address: 1465 4th Ave & 400-444 Victoria St

Fibreoptics					**Depth:**	**Connected:**
Sanitary Connection #:	4360	**Size:**	150mm	**Material:** AC	**Depth:**	**Connected:** Y
Sanitary Connection #:	2911	**Size:**	100mm	**Material:** UNK	**Depth:**	**Connected:** Y
Sanitary Connection #:		**Size:**		**Material:**	**Depth:**	**Connected:**
Sanitary Connection #:		**Size:**		**Material:**	**Depth:**	**Connected:**
Water Connection #:	4135	**Size:**	50mm	**Material:** CU	**Depth:**	**Connected:** Y
Water Connection #:	2856	**Size:**	unknown	**Material:** UNK	**Depth:**	**Connected:**
Water Connection #:		**Size:**		**Material:**	**Depth:**	**Connected:**
Water Connection #:		**Size:**		**Material:**	**Depth:**	**Connected:**
Storm Connection #:	1201	**Size:**	150mm	**Material:** AC	**Depth:**	**Connected**
Storm Connection #:		**Size:**		**Material:**	**Depth:**	**Connected**
Storm Connection #:		**Size:**		**Material:**	**Depth:**	**Connected**
Storm Connection #:		**Size:**		**Material:**	**Depth:**	**Connected**

Cash Receipt Nos:	**Water** 2362	**Sanitary** 2361	**Storm** 2040
Cash Receipt Nos:	**Water**	**Sanitary** 377	**Storm**
Cash Receipt Nos:	**Water**	**Sanitary**	**Storm**
Cash Receipt Nos:	**Water**	**Sanitary**	**Storm**

Curb from Property Line 3.048m **Pavement Width** 18.288m

Shaw
BC Hydro in lane UP 109 **U/G Connection**
Telus in lane UT 153 **U/G Connection**
Terasen in lane 3" main
Information Sheets: 345, 305
Comments:

The information contained herein is for internal use only. Not to be relied upon unless confirmed by site inspection and/or investigation.See page 2 for drawing locations

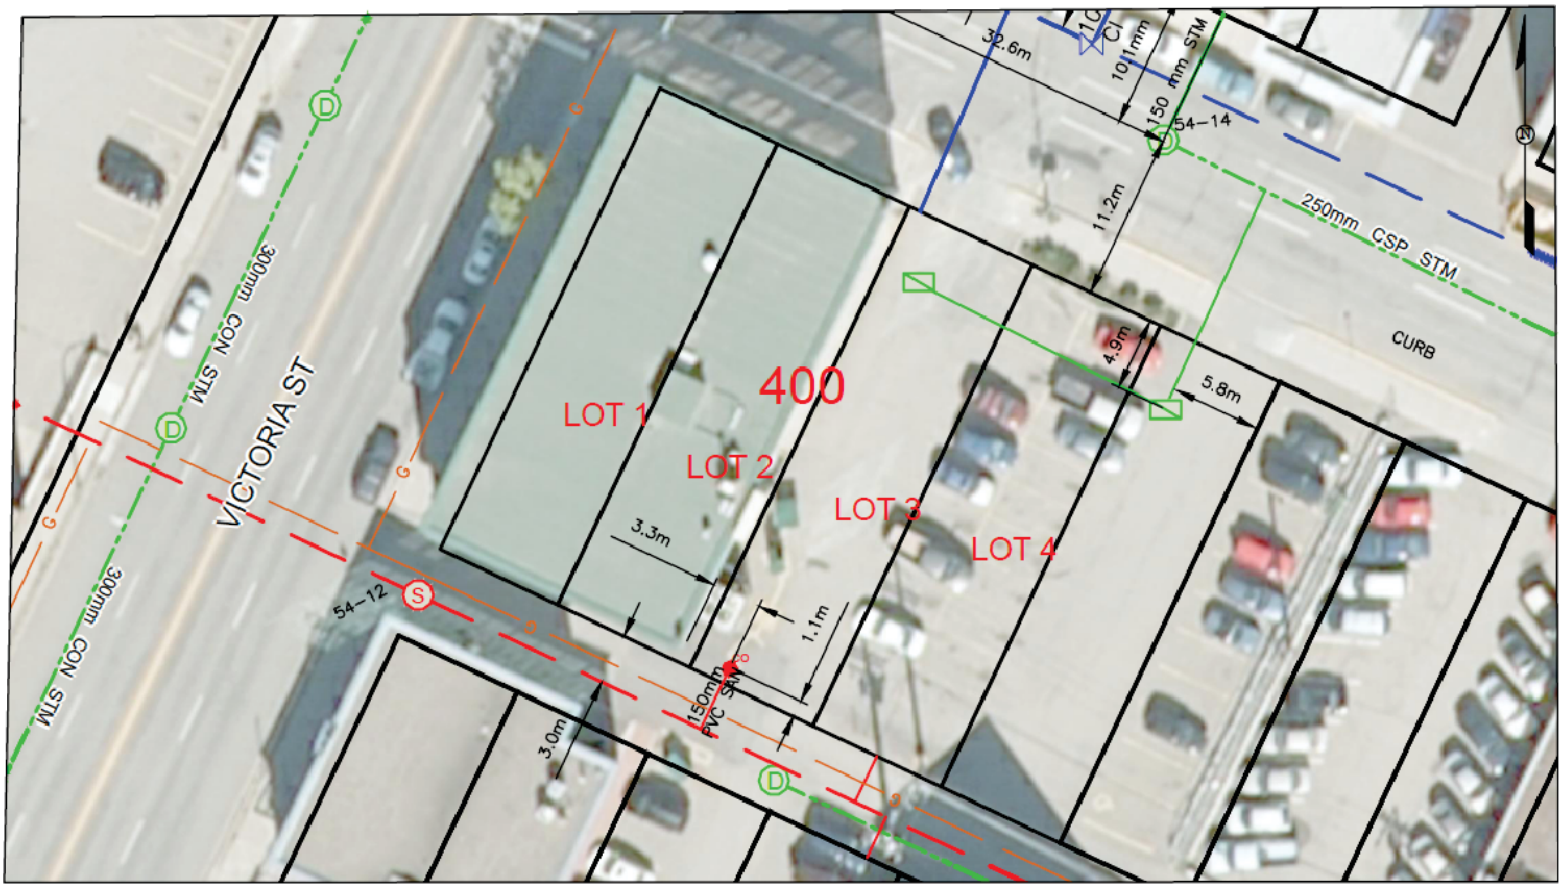

400
LOT 1
LOT 2
LOT 3
LOT 4
VICTORIA ST
300mm CON STM
300mm CON STM
250mm CSP STM
CURB
150 mm STM
150mm PVC SAN
54-12
54-14
32.6m
10.1mm
11.2m
4.9m
5.8m
3.3m
1.1m
3.0m