City of Prince George
HISTORY SHEET

SHEET NUMBER | **Roll Number** 971

Legal: LOT'S 13, 14 BLOCK 87 D.L. 937 PLAN 752

Address: 212 GILLETTE STREET

Sanitary Connection: # 7002 SIZE 4" MATERIAL A.C. INV. CONNECTED

Water Connection # 1233 SIZE 3/4" MATERIAL COPPER METER CONNECTED

Storm Connection: # SIZE MATERIAL INV. CONNECTED

Cash Receipt No's: WATER SANITARY 61 & 783 STORM

CURB FROM PROPERTY LINE PAVEMENT WIDTH

B.C. HYDRO UNDERGROUND CONNECTION

B.C. TELEPHONE UNDERGROUND CONNECTION

INLAND GAS

Information Sheets:

Comments:
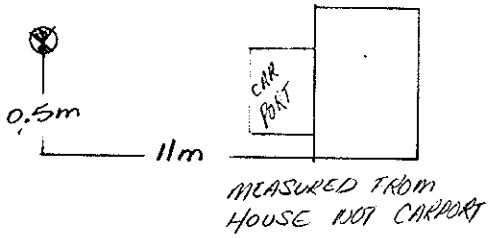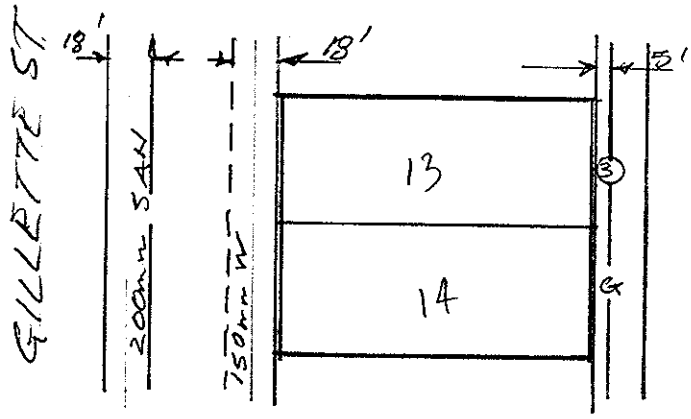
SITE PLAN N.T.S.