City of Prince George
HISTORY SHEET

007954085

SHEET NUMBER № 2705 **Roll Number**

Legal: LOT'S 91 BLOCK D.L. 905 PLAN 24848

Address: 2882 CALHOUN CRES.

Sanitary Connection: # 12790 SIZE 100mm MATERIAL INV. CONNECTED

Water Connection # 12790 SIZE 19mm MATERIAL METER CONNECTED

Storm Connection: # 1266 SIZE 100mm MATERIAL INV. CONNECTED

Cash Receipt No's: WATER SANITARY STORM

CURB FROM PROPERTY LINE PAVEMENT WIDTH

B.C. HYDRO UNDERGROUND CONNECTION

B.C. TELEPHONE UNDERGROUND CONNECTION

INLAND GAS

Information Sheets:

Comments:
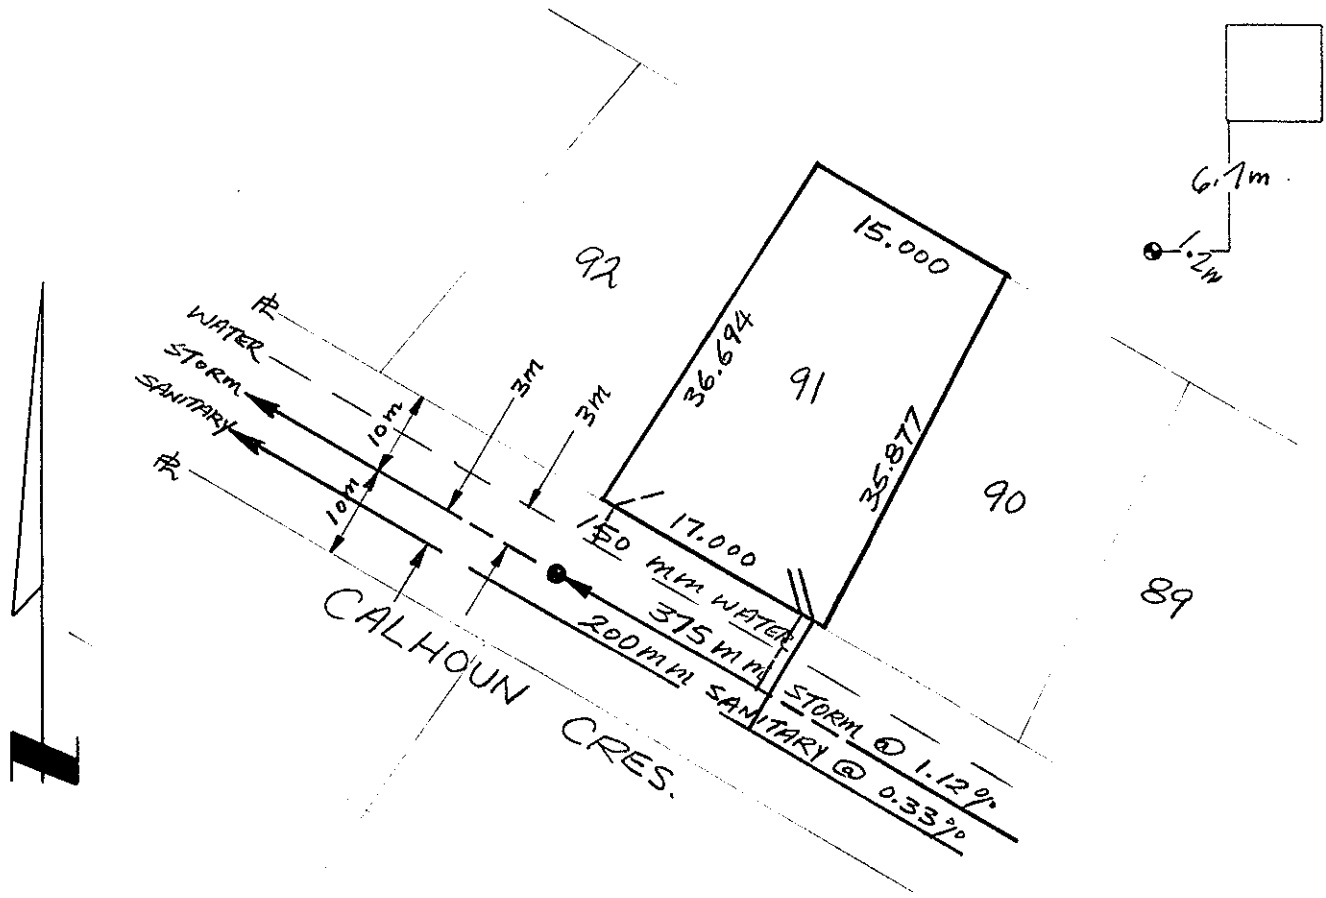
SITE PLAN N.T.S.