City of Prince George
HISTORY SHEET

SHEET NUMBER № 2044 **Roll Number**

Legal: LOT'S 1 – 6 BLOCK 59 D.L. 937 PLAN 752

Address: 461 - 485 DOUGLAS STREET

Sanitary Connection: # 1447, 1918, 1815 SIZE 100mm MATERIAL AC INV. CONNECTED

Water Connection # 1151, 11447, 1278 SIZE 38mm MATERIAL METER CONNECTED

Storm Connection: # SIZE MATERIAL INV. CONNECTED

Cash Receipt No's: WATER SANITARY STORM

CURB FROM PROPERTY LINE PAVEMENT WIDTH

B.C. HYDRO UNDERGROUND CONNECTION

B.C. TELEPHONE UNDERGROUND CONNECTION

INLAND GAS

Information Sheets:

Comments:

The information contained herein is for internal use only. Not to be relied upon unless confirmed by site inspection and/or investigation.
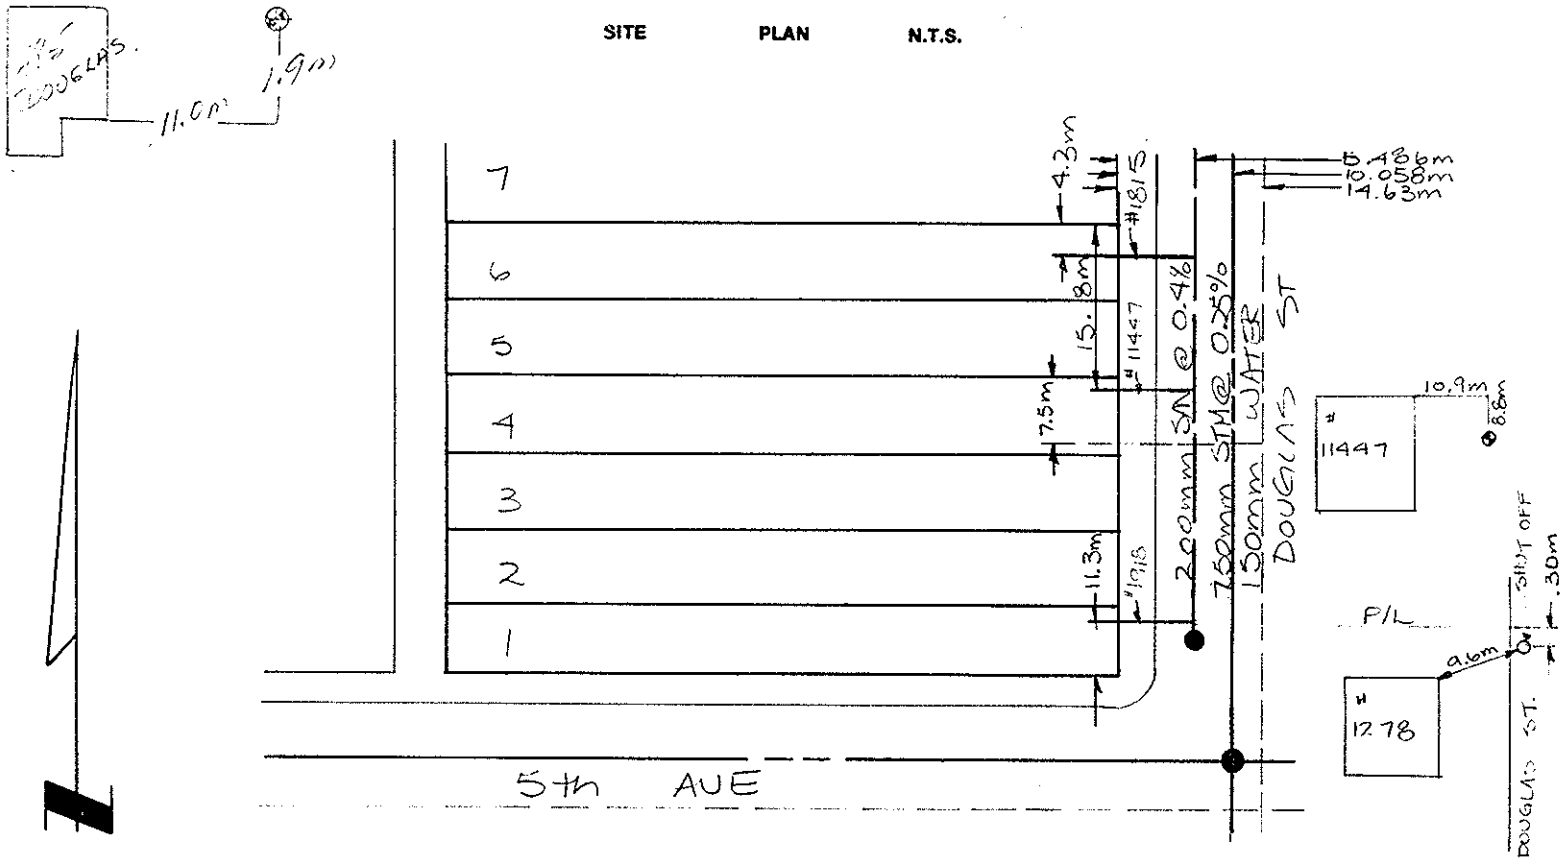
SITE PLAN N.T.S.