City of Prince George
HISTORY SHEET

007975767 HM

SHEET NUMBER

Roll Number 007975775

Legal: LOT'S 15-16 BLOCK 54 D.L. 937 PLAN 752.

Address: 430-438 Johnson St.

Sanitary Connection: # SIZE MATERIAL INV. CONNECTED

Water Connection # SIZE MATERIAL METER CONNECTED

Storm Connection: # SIZE MATERIAL INV. CONNECTED

Cash Receipt No's: WATER SANITARY STORM

CURB FROM PROPERTY LINE PAVEMENT WIDTH

B.C. HYDRO UNDERGROUND CONNECTION

B.C. TELEPHONE UNDERGROUND CONNECTION

INLAND GAS

Information Sheets:

Comments:

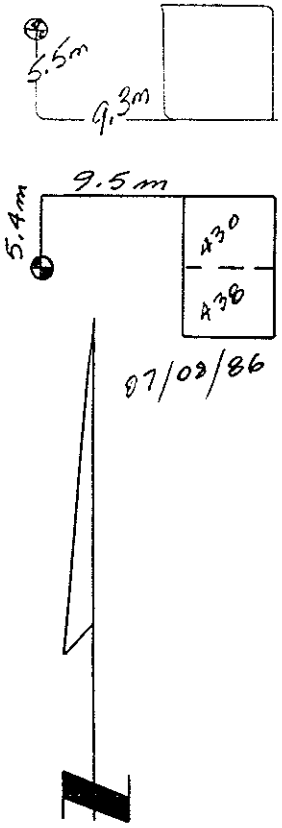

SITE PLAN N.T.S.