City of Prince George
HISTORY SHEET

008000500 1

SHEET NUMBER 1824 **Roll Number**

Legal: LOT'S 27 BLOCK — D.L. 905 PLAN 24848

Address: 4097 PRUDENTE PL.

Sanitary Connection: # 12227 SIZE 100mm ϕ MATERIAL AC INV. 37.56 CONNECTED

Water Connection # 12227 SIZE 20mm ϕ MATERIAL PVC METER CONNECTED

Storm Connection: # 1148 SIZE 100mm ϕ MATERIAL PVC INV. 37.88 CONNECTED

Cash Receipt No's: WATER SANITARY STORM

CURB FROM PROPERTY LINE 5m PAVEMENT WIDTH 10m

B.C. HYDRO UGP-234 UNDERGROUND CONNECTION

B.C. TELEPHONE UT-335 UNDERGROUND CONNECTION

INLAND GAS G-446 - 32mm GAS MAIN

Information Sheets:

Comments: BM. SIP. S.E. COR PRUDENTE & BAKER ELEV. 644.073 LEV. BK. 366
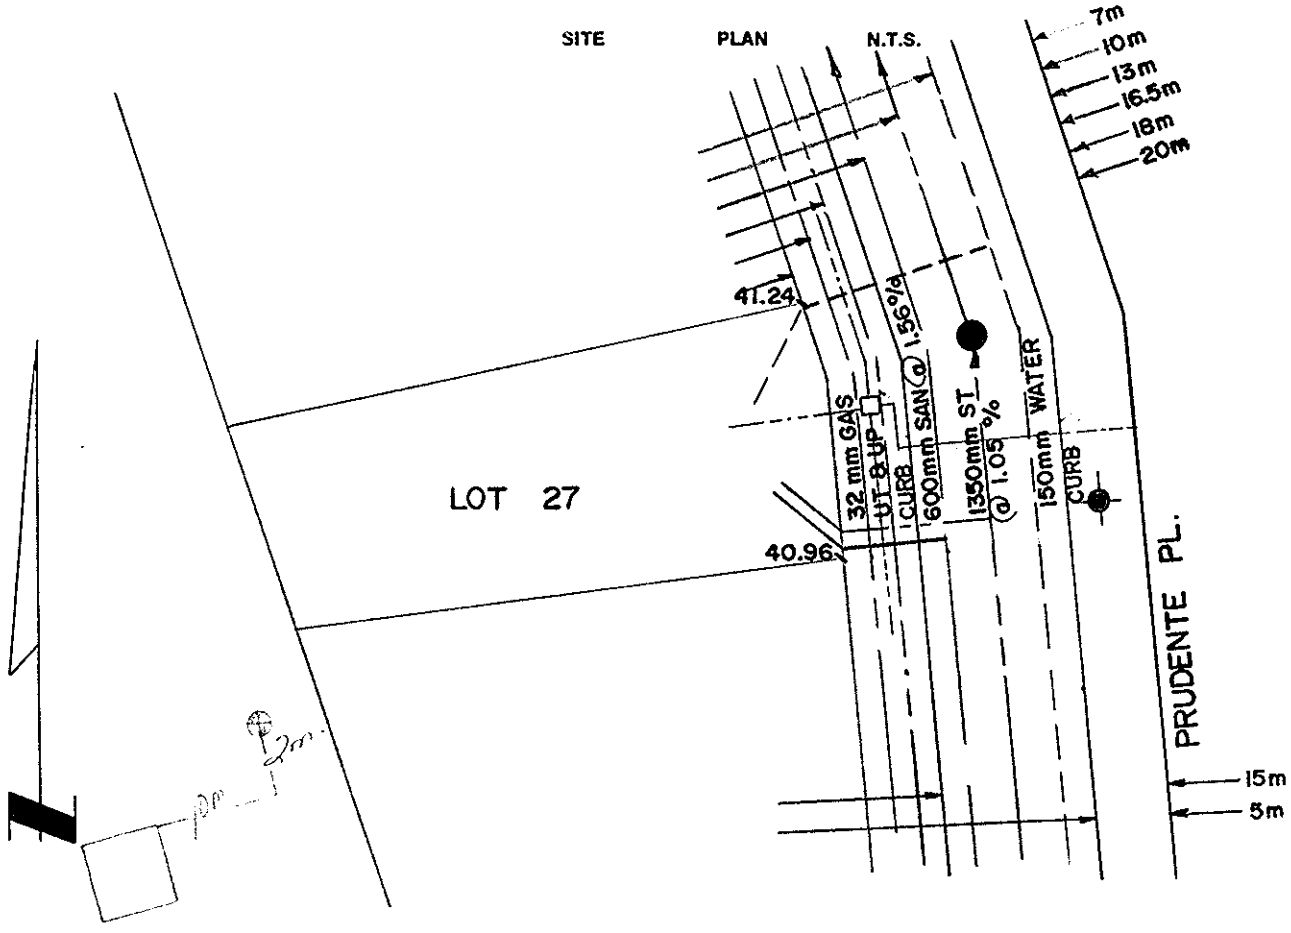
SITE PLAN N.T.S.