City of Prince George
HISTORY SHEET

SHEET NUMBER 1255 **Roll Number** 3415-000

Legal: LOT'S 10-11 BLOCK 156 D.L. 343 PLAN 1268

Address: 1725 4th AVE.

Sanitary Connection: # 67 SIZE - MATERIAL - INV. 1893.91 CONNECTED —

Water Connection # 2642 SIZE 3/4" MATERIAL Cu METER - CONNECTED —

Storm Connection: # — SIZE MATERIAL INV. CONNECTED —

Cash Receipt No's: WATER — SANITARY — STORM

CURB FROM PROPERTY LINE 10' PAVEMENT WIDTH 46'

B.C. HYDRO O.H UNDERGROUND CONNECTION —

B.C. TELEPHONE O.H UNDERGROUND CONNECTION —

INLAND GAS IN LANE 2" ϕ MAIN.

Information Sheets: —

Comments:
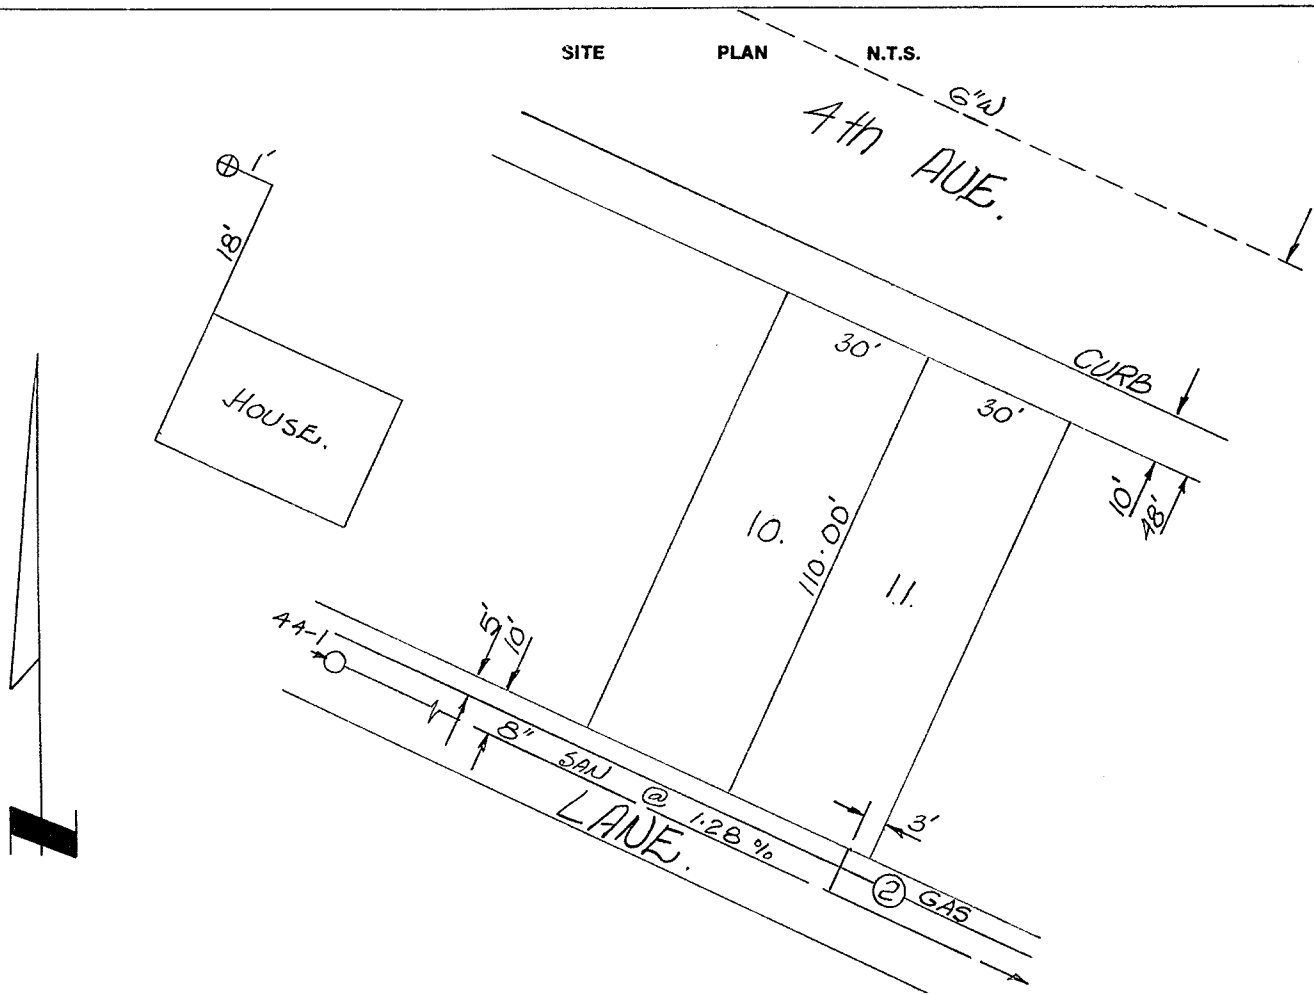
SITE PLAN N.T.S.