City of Prince George
HISTORY SHEET

5008016836 MM

SHEET NUMBER № 1433 **Roll Number** 879

Legal: LOT'S 3, 4 BLOCK 67 D.L. 937 PLAN 752

Address: 377 IRWIN STREET

Sanitary Connection: # 2795 SIZE 4" MATERIAL INV. CONNECTED

Water Connection # 1182 SIZE 3/4" MATERIAL METER CONNECTED

Storm Connection: # SIZE MATERIAL INV. CONNECTED

Cash Receipt No's: WATER SANITARY 201 STORM

CURB FROM PROPERTY LINE PAVEMENT WIDTH

B.C. HYDRO UNDERGROUND CONNECTION

B.C. TELEPHONE UNDERGROUND CONNECTION

INLAND GAS

Information Sheets:

Comments:
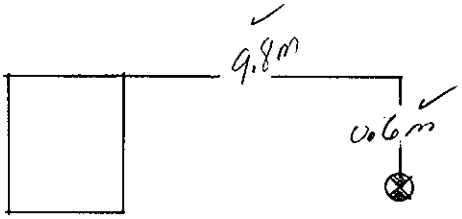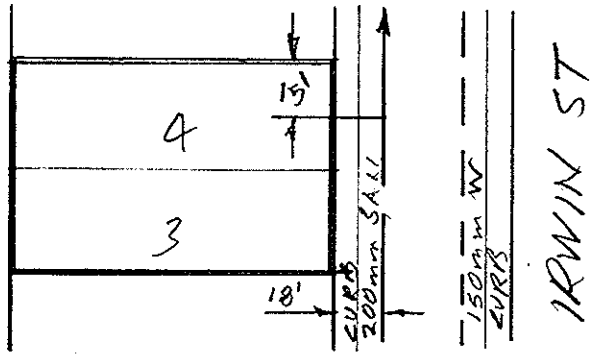
SITE PLAN N.T.S.